

DEC 12 1997

COMMISSION

LAND CORNER RECORDATION CERTIFICATE
Filing Requirement of Act 74, Mich. P.A. 1970

For corners in

EATON
(County)
KALAMIO TOWNSHIP
1. Public Land Survey

Located In:	Corner Code #
T <u>2N</u> R <u>6W</u>	<u>C-12</u>
T _____ R _____	_____
T _____ R _____	_____
T _____ R _____	_____
S _____ T _____ R _____	_____
S _____ T _____ R _____	_____
S _____ T _____ R _____	_____
S _____ T _____ R _____	_____

2. Property Controlling in Section
3. Miscellaneous Property in Sec.

4. Lot No. _____, Recorded Plat _____
5. Private Claims _____

I, DAVID R. LOHR, in a field survey on JUNE 9, 19 97 do hereby state that under requirements of P.A. 74, Michigan P.A. of 1970, the corner points mentioned in lines 1 and 2 above were in conformance with regulations and rules therefore as required in the current manual of survey instructions of the United States Department of the Interior, Bureau of Land Management or by a decree of a Court of Law and /or that the corner points mentioned in lines 3, 4 and 5 above were in conformance with the rules of the Michigan Board of Land Surveyors or by a Decree of a Court of Law; established, re-established, monumented, recovered, found as expressed below:

NOTE: Not more than 2 corners, all in the same town and range, may be recorded on this certificate.

A. Description of original monument and accessories and/or subsequent restoration:

C-12: 1. POST SET BY MUSGROVE EVANS, U.S. DEP. SURVEYOR IN 1826.
WITNESSED BY: BEECH 9" S 68 W 22 LKS. (14.52')
" 12" N 10 E 20 LKS. (13.20')
NOTES SHOW DISTANCE NORTH AND SOUTH OF 40.00 CH. (2640.00')


CONTINUED ON BACK

B. Description of corner evidence found and/or method applied in restoring or reestablishing corner:

C-12: SEARCHED AT APPARENT LOCATION OF CORNER AND FOUND 1" ANGLE IRON AS PER ITEM #A-3. CORNER IS SET FLUSH WITH GROUND AND SET IN STONES ABOUT 1 FOOT NORTH OF EAST-WEST FENCE AND ON PROJECTION OF FENCE ABOUT 20 FT. SOUTH. FOUND BOTH OF SURVEYOR DAVIS'S WITNESS TREES. ACCEPTED ANGLE IRON AS BEST EVIDENCE OF CORNER LOCATION. TRAVERSED ENTIRE SECTIONS 30 AND 31, AND MEASURED SOUTH 2624.14 FT. TO C-13 AND WEST 5620.50 FT. TO A-12. SET 3/4" X 24" STANDARD REMON. BAR AND PA 345 CAP #30090 IN INTERIOR CORNER OF 1" ANGLE IRON.

C. Description of monument for corner and accessories established to perpetuate locating the position of the corner:

C-12: SET 3/4" X 24" STANDARD REMON. BAR AND PA 345 CAP #30090 AT 1" ANGLE IRON IN STONES.
WITNESSED BY:
SET N/T #30090, N/S 8" BASSWOOD, EAST, 8.85'
SET N/T #30090, W/S 30" BASSWOOD, SOUTH, 19.15'
SET N/T #30090, N/S 24" BASSWOOD, WEST, 33.36'
SET N/T #30090, S/S 8" BASSWOOD, N 70 W, 14.91'

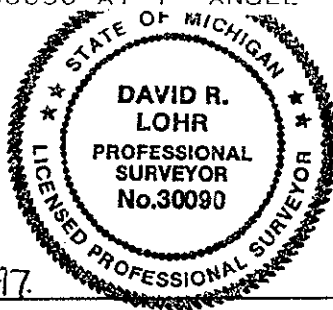

Signed by David R. Lohr
Surveyor's Michigan License No. 30090

Date 7-23-97

FILED
Copy
97 AUG 12 AM 11: 25

LINDA M. TWITCHELL
REGISTER OF DEEDS
EATON COUNTY, MICH.

LIBER 3 PAGE 786

Register of Deeds Stamp & File Number

	A	B	C	D	E	F	G	H	I	J	K	L
1												
2	6		5		4		3		2		1	
3												
4	7		8		9		10		11		12	
5												
6	18		17		16		15		14		13	
7												
8	19		20		21		22		23		24	
9												
10	30		29		28		27		26		25	
11												
12	31		32		33		34		35		36	
13												

C-12: KALAMO TOWNSHIP, PART-A, CONTINUED

2. CORNER REFERENCED IN SURVEY BY OSCAR CHURCH, COUNTY SURVEYOR. DATED MAY 18, 1875 AND RECORDED IN VOL. 1, PG. 226. AS "STONE, FOBT&S.". NO WITNESSES GIVEN. SURVEY SHOWS DISTANCE NORTH OF 39.85 CH. (2630.10'), EAST OF 40.30 CH. (2659.80') AND SOUTH OF 39.92 CH. (2634.72').
3. CORNER RERERENCED IN PRIVATE RECORDS OF DONALD J. DAVIS, LPS #17617, DATED 1973, AS "E 1/4 POST, (SEC. 31, KALAMO), 1" ANGLE IRON, 1' NORTH OF E&W FENCE." WITNESSED BY:

30" MAPLE,	SOUTH,	19.2'
20" MAPLE,	WEST,	32.5'
4. NO OTHER REFERENCES FOUND.