

SURVEY &
REMONUMENTATION

NOV 10 1993

FILED

COMMISSION

LAND CORNER RECORDATION CERTIFICATE

Filing Requirement of Act 74, Mich. P.A. 1970

93 OCT 27 AM 9: 57

For corners in

<u>Eaton</u> (County)	Located In:	Corner Code #/
1. Public Land Survey	T <u>3N</u> R <u>3W</u>	<u>I-10</u>
	T _____ R _____	_____
	T _____ R _____	_____
	T _____ R _____	_____
2. Property Controlling in Section	S _____ T _____ R _____	_____
	S _____ T _____ R _____	_____
3. Miscellaneous Property in Sec.	S _____ T _____ R _____	_____
	S _____ T _____ R _____	_____
4. Lot No. _____, Recorded Plat _____		
5. Private Claims _____		

LINDA M. TWITCHELL
REGISTER OF DEEDS
EATON COUNTY, MICH.

Liber 3 Page 301

Register of Deeds Stamp & File Number

I, Larry A. Bryan, in a field survey on August 28, 19 93, do hereby certify that under requirements of P.A. 74, Michigan P.A. of 1970, the corner points mentioned in lines 1 and 2 above were in conformance with regulations and rules therefore as required in the current manual of survey instructions of the United States Department of the Interior, Bureau of Land Management or by a decree of a Court of Law and/or that the corner points mentioned in lines 3, 4 and 5 above were in conformance with the rules of the Michigan Board of Land Surveyors or by a Decree of a Court of Law; established, re-established, monumented, re-monumented, recovered, found as expressed below:

NOTE: Not more than 4 corners, all in the same town and range, may be recorded on this certificate.

	A	B	C	D	E	F	G	H	I	J	K	L	M
2	6	5	4	3	2	1							
3													
4	7	8	9	10	11	12							
5													
6	18	17	16	15	14	13							
7													
8	19	20	21	22	23	24							
9													
10	30	29	28	27	26	25							
11													
12	31	32	33	34	35	36							
13													

A. Description of original monument and accessories and/or subsequent restoration:
I-10,

- In 1827, Musgrove Evans, U.S. Deputy Surveyor, Set 1/4 Sec post
Beech 24 N36E 34
Do 6 S25W 24

(Continued on Back)

B. Description of corner evidence found and/or method applied in restoring or reestablishing corner:


I-10, Investigation at this corner location revealed a 1/2" bar and cap #18988 3' West of the centerline of Smith Road. The witnesses to the Hickory 10", N49°E, in #3 above and the Fluke witnesses check with the location of the 1/2" bar, therefore it was accepted as the perpetuated location of I-10.

C. Description of monument for corner and accessories established to perpetuate locating the position of the corner:

- I-10, T3N-R3W
Found 1/2" bar and cap #18988 as noted above
Set nail & tag #25832 South side 24" Hickory, N32°E, 43.51'
Set nail & tag #25832 East side 20" Walnut, S10°W, 80.28'
Set nail & tag #25832 North side 24" Walnut, West, 36.04'
Set nail & tag #25832 Northeast side 24" Walnut, S40°E, 47.20'

Signed by Larry A. Bryan
Surveyor's Michigan License No. 25832

Date 10-13-93

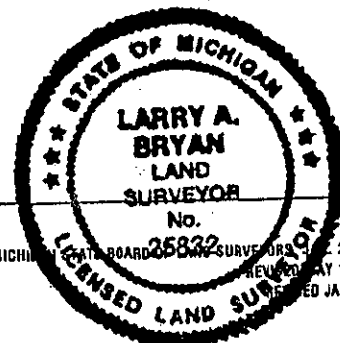

FORM APPROVED BY MICHIGAN BOARD OF LAND SURVEYORS
REVISED MAY 14, 1991
EFFECTIVE JAN., 1992

P.A. 345 EATON COUNTY
PEER APPROVED 9/29/93 RL

PART "A" CONTINUED

2. William Swampler, County Surveyor, recorded corner on August 8, 1872 (Vol.1 P.164 of County Surveyor Records), as a "Stake" with the following witness:

B. Walnut 10 N81E 87

3. H.A. Williams, County Surveyor, recorded corner on August 15, year unreadable (Vol.4 P.57 of County Surveyor Records), as having established 1/4 post by finding I-9 and I-11 from previous surveys and setting an iron shaft at an average distance between corners with the following witnesses:

Hickory 10" N.49°E. 44.3'

Elm 12" N.50°W. 25.5'

4. Kay Don Fluke, LS #18988, recorded corner on 02/07/74 in Liber 1 of Corners, Page 388, and in Liber 1 of Surveys, Page 146, as having found remains of 4" rotted stake 18" below road surface, and raising it with a 1/2" rod with the following witnesses:

N30W 35.85 Walnut 12"

N32E 43.51 Hickory 21"

S40E 47.20 Walnut 16"

S10W 80.28 Walnut 16"

Due West 36.04 Walnut 20"

5. Kay Don Fluke, LS #18988, recorded corner on 05/11/86 in Liber 4 of Surveys, Pages 29-30, with no particular monument noted, with the following witnesses:

N30W 35.85 Walnut 12"

West 36.04 Walnut 20"

S10W 80.28 Walnut 16"



29-27-86

RECORDED AND INDEXED
APR 11 1986