

SURVEY &
REMONUMENTATION

NOV 10 1993

COMMISSION

LAND CORNER RECORDATION CERTIFICATE
Filing Requirement of Act 74, Mich. P.A. 1970

FILED

93 OCT 27 AM 9:56

For corners in

<u>Eaton</u> (County)	Located In:	Corner Code #
1. Public Land Survey	T <u>3N</u> R <u>3W</u>	<u>I-11</u>
	T _____ R _____	_____
	T _____ R _____	_____
	T _____ R _____	_____
2. Property Controlling in Section	S _____ T _____ R _____	_____
	S _____ T _____ R _____	_____
3. Miscellaneous Property in Sec.	S _____ T _____ R _____	_____
	S _____ T _____ R _____	_____
4. Lot No. _____, Recorded Plat _____		
5. Private Claims _____		

LINDA M. TWITCHELL
REGISTER OF DEEDS
EATON COUNTY, MICH.

Register of Deeds Stamp & File Number

I, Larry A. Bryan, in a field survey on September 9, 19 93, do hereby certify that under requirements of P.A. 74, Michigan P.A. of 1970, the corner points mentioned in lines 1 and 2 above were in conformance with regulations and rules therefore as required in the current manual of survey instructions of the United States Department of the Interior, Bureau of Land Management or by a decree of a Court of Law and/or that the corner points mentioned in lines 3, 4 and 5 above were in conformance with the rules of the Michigan Board of Land Surveyors or by a Decree of a Court of Law; established, re-established, monumented, re-monumented, recovered, found as expressed below:

A	B	C	D	E	F	G	H	I	J	K	L	M
2	6	5	4	3	2	1						
3												
4	7	8	9	10	11	12						
5												
6	18	17	16	15	14	13						
7												
8	19	20	21	22	23	24						
9												
10	30	29	28	27	26	25						
11												
12	31	32	33	34	35	36						
13												

NOTE: Not more than 4 corners, all in the same town and range, may be recorded on this certificate.

A. Description of original monument and accessories and/or subsequent restoration:
I-11,

- In 1827, Musgrove Evans, U.S. Deputy Surveyor, Set Post cor Secs. 26, 27, 34 & 35
Lynn 20 N43E 37
Birch 16 N87W 24

(Continued on Back)

B. Description of corner evidence found and/or method applied in restoring or reestablishing corner:


I-11, Investigation at this corner location revealed a 3/4" pipe in a monument box in the centerline intersection of Smith Road and Rossman Highway. The anchor posts in Item #2 appear to have been replaced with a steel post and a new wood corner post. The MSHD witnesses and Marvin Fouty checked closely with the location of the pipe, therefore the pipe was accepted as the perpetuated location of I-11.

C. Description of monument for corner and accessories established to perpetuate locating the position of the corner:

- I-11, T3N, R3W
3/4" pipe in a monument box as noted above.
Found MSHD nail and tag in Northeast side utility pole, N35°W, 75.23'
Found MSHD nail and tag in Northeast side of wood post, S42°E, 44.04'
Set nail and tag #25832 in Northwest side guy pole, S67°W, 53.62'
Set nail and tag #25832 in West side 12" Elm, N10°E, 182.99'

Signed by Larry A. Bryan
Surveyor's Michigan License No. 25832

Date 10-13-93

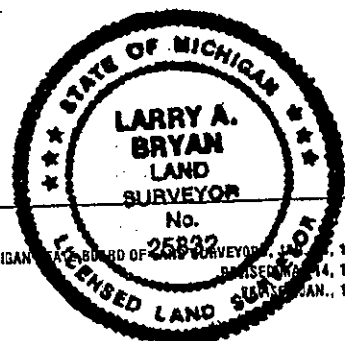

P.A. 345 EATON COUNTY
PEER APPROVED 9/29/93 m

FORM APPROVED BY MICHIGAN BOARD OF LAND SURVEYORS

PART "A" CONTINUED

2. Corner recorded to be a stone by County Surveyor William Swampler on August 8th, 1872 (Vol.1 P.164 of County Surveyor Records), with no witnesses.
3. Corner recorded to be a stone with a brick on the end by County Surveyor H. A. Williams on August 15, year unreadable (Vol.4 P.57 of County Surveyor Records), with the following witnesses:
Anchor post, S46°E, 46.0'
Anchor post, NE, 48.5'
Telephone pole, S47°W, 43.0'
4. The Michigan Department Of State Highways (MDSH) on 05/23/73 with Philip Wetoskey, LS #19847, as the Survey Chief, found a 1/2" pipe with the following witnesses (from MDSH Witness Records):
N35°W, 75.34', P.P. & T.P.
N45°E, 46.18', Steel fence post
S67°W, 53.62', Guy Pole
S42°E, 43.99, Wood corner post
5. N.C. Jones, LS #02934, recorded corner on 05/23/74 in Liber 2 of Corners, Page 166, as having found a 1/2" iron pipe near the center of the intersection of Smith and Rossman Roads, but did not find a stone, with the same witnesses as #4 above.
6. Richard Steadman, LS #11370, recorded corner on 11/18/83 in Liber 3 of Surveys, Page 623, as having found a 1/2" iron pipe per witnesses listed in #4 above.
7. Marvin F. Fouty, LS #18989, recorded corner on 08/23/85 in Liber 3 of Surveys, Page 870, as having found a 1/2" pipe with the following witnesses:
MSHD tag in P. Pole, N45°W, 75.28'
MSHD tag in fence post, S45°E, 44.05'
Center 3" Steel anchor post, N45°E, 46.25'
8. Kay Don Fluke, LS #18988, witnessed a 1/2" pipe with same witnesses as #4 above. (Date unknown, Private Records)

