

NOV 10 1993

FILED

COMMISSION

LAND CORNER RECORDATION CERTIFICATE
Filing Requirement of Act 74, Mich. P.A. 1970

93 OCT 27 AM 9:58

For corners in

<u>Eaton</u> (County)	Located In:	Corner Code #
1. Public Land Survey	T <u>3N</u> R <u>3W</u>	<u>K-9</u>
	T _____ R _____	_____
	T _____ R _____	_____
	T _____ R _____	_____
2. Property Controlling in Section	S _____ T _____ R _____	_____
	S _____ T _____ R _____	_____
3. Miscellaneous Property in Sec.	S _____ T _____ R _____	_____
	S _____ T _____ R _____	_____
4. Lot No. _____, Recorded Plat _____		
5. Private Claims _____		

LINDA M. TWITCHELL
REGISTER OF DEEDS
EATON COUNTY, MICH.

Liber 3 Page 315

Register of Deeds Stamp & File Number

I, Larry A. Bryan, in a field survey on September 10, 19 93, do hereby certify that under requirements of P.A. 74, Michigan P.A. of 1970, the corner points mentioned in lines 1 and 2 above were in conformance with regulations and rules therefore as required in the current manual of survey instructions of the United States Department of the Interior, Bureau of Land Management or by a decree of a Court of Law and/or that the corner points mentioned in lines 3, 4 and 5 above were in conformance with the rules of the Michigan Board of Land Surveyors or by a Decree of a Court of Law; established, re-established, monumented, re-monumented, recovered, found as expressed below:

	A	B	C	D	E	F	G	H	I	J	K	L	M
2	6	5	4	3	2	1							
3													
4	7	8	9	10	11	12							
5													
6	18	17	16	15	14	13							
7													
8	19	20	21	22	23	24							
9													
10	30	29	28	27	26	25							
11													
12	31	32	33	34	35	36							
13													

NOTE: Not more than 4 corners, all in the same town and range, may be recorded on this certificate.

A. Description of original monument and accessories and/or subsequent restoration:
K-9,

- In 1827, Musgrove Evans, U.S. Deputy Surveyor, Set Post cor Secs. 23, 24, 25 & 26
Beech 20 N35E 9
Beech 4 N88W 18

(Continued on Back)

B. Description of corner evidence found and/or method applied in restoring or reestablishing corner:

K-9, Investigation at this corner location revealed a 3/8" rod with a brass cap in a monument box in the extended centerline of Vermontville Highway, ±2' Southeast of the centerline of Bailey Road, 44.4' East of the centerline of existing Northbound M-99. The Stephens survey and highway plans for M-99 from the Michigan State Highway Department record a distance of 2631.46' between J-9 and K-9. The centerline of M-99 was relocated and no additional information was provided by MDOT. No excavation was conducted due to State Highway being built with undercut and fill of area. All of the witnesses listed in Items #2 - #6 above remain (except the 6" Walnut Northeast) and check closely with the location of the 3/8" rod, therefore it was accepted as the perpetuated location of K-9.


C. Description of monument for corner and accessories established to perpetuate locating the position of the corner:

- K-9, T3N-R3W
Found 3/8" rod with brass cap in monument box as noted above.
Found MDSH nail and tag West side utility pole, S20°E, 28.47'
Found MDSH nail and tag West side utility pole, N05°E, 152.85'
Set nail & tag #25832 West side 12" Cherry, N75°E, 54.83'
Chiseled "X" on top of South end concrete culvert, S75°W, 101.58'

Signed by Larry A. Bryan Date 10-15-93
Surveyor's Michigan License No. 25832

P.A. 345 EATON COUNTY
PEER APPROVED 10/13/93

FORM APPROVED BY MICHIGAN BOARD OF LAND SURVEYORS, JAN 2, 1971
REVISED BY MICHIGAN BOARD OF LAND SURVEYORS, 1971

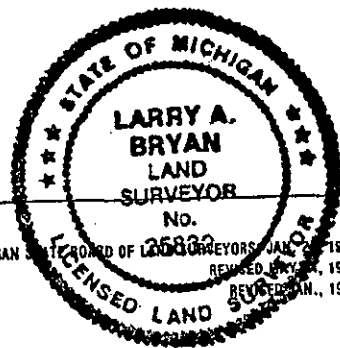

PART "A" CONTINUED

2. Philip Wetoskey, LS #19847, of the Michigan Department of State Highways, recorded corner on 04/09/73 in Liber 1 of Corners, Page 269, as having found a 3/8" Iron Rod from ties on old highway plans and placed a monument box over it witnessed by:
Nail & MDSH Tag in Power & Telephone Pole S20°E 28.53'
Nail & MDSH Tag in 6" Walnut N20°E 95.27'
Face of Steel Sign Post S40°E 67.90'

3. Ron Helsel, LS #18994, recorded corner on 08/27/73 in Liber 1 of Corners, Page 316, as having found a 3/8" re-rod in Monument Box 32.91' off centerline to East with the same witnesses as listed in Item #2 above.

4. Fred N. White, LS #12034, recorded corner on 09/19/73 in Liber 1 of Surveys, Page 467, as having found a 3/8" re-rod in Mon Box 32.? East of centerline M-99 with the same witnesses as listed in Item #2 above.

5. James E. Stephens, LS #16053, recorded corner on 07/21/76 in Liber 2 of Surveys, Page 102, as having found a 3/8" re-rod in mon. box with the same witnesses as listed in Item #2 above.

6. Ken Emmons, P.E. #13675, of the Michigan Department of State Highways, witnessed corner on 10/02/80 as a "Mon. Box/Copper Survey Marker" witnessed by :

P.P. N05°E 153.02'

7" Cherry N77°E 54.83'

P.P. S22°30'E 28.49'

(from MDSH witness notes)

