

FEB 22 1986
 SUBMISSION

FILED
 Copy

95 DEC -4 PM 4: 11

LAND CORNER RECORDATION CERTIFICATE
Filing Requirement of Act 74, Mich. P.A. 1970

For corners in **Benton Twp.**

LINDA M. TWITCHELL
 REGISTER OF DEEDS
 EATON COUNTY, MICH.

<u>Eaton</u> (County)	Located In:	Corner Code \neq
1. Public Land Survey	T <u>3N</u> R <u>4W</u>	<u>L-10</u>
	T _____ R _____	_____
	T _____ R _____	_____
	T _____ R _____	_____
2. Property Controlling in Section	S _____ T _____ R _____	_____
	S _____ T _____ R _____	_____
3. Miscellaneous Property in Sec.	S _____ T _____ R _____	_____
	S _____ T _____ R _____	_____

LINDA M. TWITCHELL
 Register of Deeds Stamp & File Number

4. Lot No. _____, Recorded Plat _____
 5. Private Claims _____

	A	B	C	D	E	F	G	H	I	J	K	L	M
2	6		5		4		3		2		1		
3													
4	7		8		9		10		11		12		
5													
6	18		17		16		15		14		13		
7													
8	19		20		21		22		23		24		
9													
10	30		29		28		27		26		25		
11													
12	31		32		33		34		35		36		
13													

Larry A. Bryan, in a field survey on October 27, 19 95
 do hereby certify that under requirements of P.A. 74, Michigan P.A. of 1970, the corner points mentioned
 in lines 1 and 2 above were in conformance with regulations and rules therefore as required in the
 current manual of survey instructions of the United States Department of the Interior, Bureau of Land
 Management or by a decree of a Court of Law and/or that the corner points mentioned in lines 3, 4 and 5
 above were in conformance with the rules of the Michigan Board of Land Surveyors or by a Decree of a
 Court of Law; established, re-established, monumented, re-monumented, recovered, found as
 expressed below:

**NOTE: Not more than 4 corners, all in the same town and range, may be recorded
 on this certificate.**

1. Description of original monument and accessories and/or subsequent restoration:

L-10,

1. Corner not set in Original Government Survey.
2. Corner identified in a survey by O.G. Church, County Surveyor, on
 March 27, 1876 (vol. 2, page 26 and 27 County Surveyor Records) as stone
 and crockery with no witnesses given.


No other reference for this corner could be found.

3. Description of corner evidence found and/or method applied in restoring or reestablishing corner:

L-10, Excavated area 3.0' x 3.0' to a depth of 1.5' generally in the
 centerline of King Highway, on fence line to the South. Found a 0.8' x
 0.5' pointed red granite stone 0.5' below the gravel surface \pm 2.0' North
 of the centerline of King Highway and on the fence line South. Just
 below and on the North side of the red granite stone was 1/2 of a broken
 blue-green stone 0.7' x 0.4'. The blue-green stone was supporting the
 North edge of the red granite stone. The location of the red granite
 stone is 1.6 feet South of the line between K-10 and M-10 Benton
 Township. Accepted the red granite stone as center of section 10 as set
 by O.G. Church in March of 1876 and replaced with 3/4" x 24" bar with
 cap stamped P.A. 345 #25832. Measured West to K-10 2633.64' and East to
 M-10 2618.50'.

4. Description of monument for corner and accessories established to perpetuate locating the position of the corner:

L-10, T3N-R4W
 Set 3/4" x 24" bar with cap stamped P.A. 345 #25832 \pm 2.0'
 North of the centerline of King Highway on fence line South.
 Set nail & tag #25832 in East side anchor post, South 27.92'.
 Set nail & tag #25832 in East side fence post, S20°W, 29.15'.
 Set nail & tag #25832 in North side 6" Aspen, S65°W, 43.44'.
 Found 3/4" pipe in monument box, West 1/4 corner Section 25,
 T3N, R4W, West, 2623.64'.

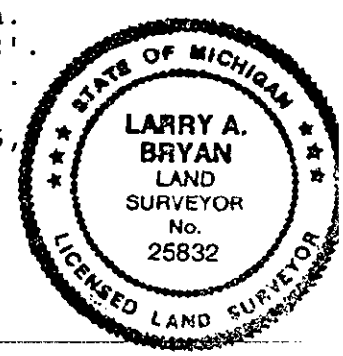

Signed by Larry A. Bryan
 Surveyor's Michigan License No. 25832

Date 11-7-95

P.A. 345 EATON COUNTY
 PEER APPROVED 11/7/95 M