SURVEY & REMONUMENTATION

DEC 1 6 1996

COMMISSION

Liber 3 pg 756

FILED

Copy

96 NOV 27 AM 8: 57

LINDA M. TWITCHELL
REGISTER OF DEEDS
EATON COUNTY, MICH.

Register of Deeds Stamp & File Number

LAND CORNER RECORDATION CERTIFICATE
Filing Requirement of Act 74, Mich. P.A. 1970

For corners:

EATON COUNTY

CHESTER TOWNSHIP
Located In: Corner Code #

1. Public Land Survey		T 3N	R 5W	A-7
		T___	R___	
		T___	R___	
		T___	R___	
2. Property Controlling	S___	T___	R___	
in Section	S___	T___	R___	
3. Miscellaneous	S___	T___	R___	
Property in Sec.	S___	T___	R___	

4. Lot No. _____ , Recorded Plat _____
5. Private Claims _____

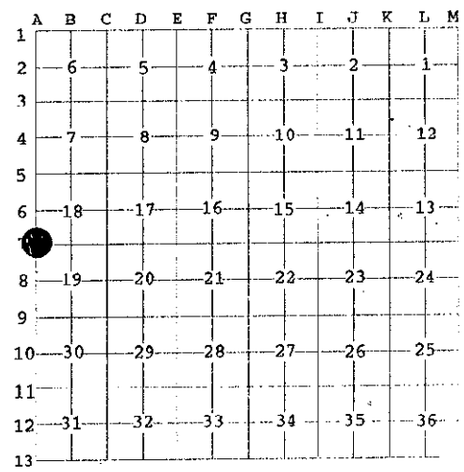

I, Maurice H. Mahieu, in a field survey on Oct. 9, 1996 do hereby certify that under requirements of P.A. 74, Michigan P.A. of 1970, the corner points mentioned in lines 1 and 2 above were in conformance with regulations and rules therefore as required in the current manual of survey instructions of the United States Department of the Interior, Bureau of Land Management or by a decree of a Court of Law and /or that the corner points mentioned in lines 3, 4 and 5 above were in conformance with the rules of the Michigan Board of Land Surveyors or by a Decree of a Court of Law; established, re-established, monumented, re-monumented, recovered, found as expressed below:

NOTE: Not more that 4 corners, all in the same town and range, may be recorded on this certificate.

A. Description of original monument and accessories and/or subsequent restoration:
1. Orange Risdon, US Deputy Surveyor, on March 19, 1827 states "Set post corner Sec. 18 & 19, W. Maple 8 N49E 15, Elm 13 S45E 46, Intersect W. Bdy. 20 lks. S. of post"

2. O. G. Church, County Surveyor on Feb. 26, 1876 in Book 2, Page 6 & 7, notes "Stone set by Gibbons". No witnesses given.

B. Description of corner evidence found and/or method applied in restoring or reestablishing corner:
Location of corner is in ten foot fill area of Gresham Highway. Did not excavate at the location of corner. With a mutual effort by myself and Ron Enger, PS 28409, the location of M-7, Vermontville Twp., T3N, R6W, and the location of this corner was establish simultaneously. A-7 was determined to be lost and established on the Township line at the GLO distance of 20 links (13.2 feet) south of M-7. Corner falls 8.5 feet south of centerline of Gresham Highway (gravel road) and west of Thornapple River.

C. Description of monument for corner and accessories established to perpetuate locating the position of the corner:
Set 3/4" iron rod with cap stamped "PA 345 PS 28414"; witnessed by:
Nail and tag #25837 (Dave Clifford, PS) northeast side 28" Oak 147°Naz 27.62 feet
Nail and tag #25837 north side 18" Hackberry, 263°Naz, 56.80 feet
Nail and tag #25837 north side 30" Hackberry, 267°Naz, 116.80 feet
Nail and tag #25837 east side 18" Ash, 351°Naz 41.32 feet
Northwest corner west abutment of bridge, 62°Naz, 39.20 feet
Southwest corner west abutment of bridge, 100°Naz, 32.66 feet
M7 (Vermontville Twp.) 13.2' N

Signed by Maurice H Mahieu Date 11-15-96

Surveyor's Michigan License No. 28414

SURVEYOR NO. 28414 LICENSED PROFESSIONAL SURVEYOR

FORM APPROVED BY MICHIGAN STATE BOARD OF LAND SURVEYORS, JAN. 28, 1971
REVISED MAY 14,1975
REVISED JAN., 1983

P.A. 345 EATON COUNTY
PEER APPROVED 10/17/96 M