

**SURVEY &
REMONUMENTATION**

APR 27 1995

LAND CORNER RECORDATION CERTIFICATE
Filing Requirement of Act 74, Mich. P.A. 1970
CHESTER TOWNSHIP

FILED
COPY

94 DEC -1 AM 9:41

For corners of **COMMISSION**
EATON
(County)


Located In: Corner Code #/

- | | | |
|------------------------------------|-------------------------|------------|
| 1. Public Land Survey | T <u>3N</u> R <u>5W</u> | <u>E-5</u> |
| | T _____ R _____ | _____ |
| | T _____ R _____ | _____ |
| | T _____ R _____ | _____ |
| 2. Property Controlling in Section | S _____ T _____ R _____ | _____ |
| | S _____ T _____ R _____ | _____ |
| 3. Miscellaneous Property in Sec. | S _____ T _____ R _____ | _____ |
| | S _____ T _____ R _____ | _____ |

LINDA M. TWITCHELL
REGISTER OF DEEDS
EATON COUNTY, MICH.

LIBER 3 Pg 555
Register of Deeds Stamp & File Number

4. Lot No. _____, Recorded Plat _____
5. Private Claims _____

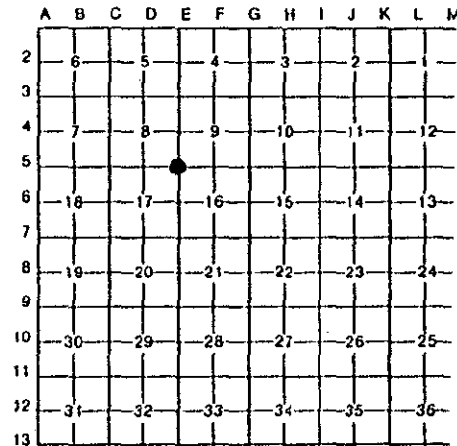

I, Maurice H. Mahieu, in a field survey on October 27, 1994, do hereby certify that under requirements of P.A. 74, Michigan P.A. of 1970, the corner points mentioned in lines 1 and 2 above were in conformance with regulations and rules therefore as required in the current manual of survey instructions of the United States Department of the Interior, Bureau of Land Management or by a decree of a Court of Law and/or that the corner points mentioned in lines 3, 4 and 5 above were in conformance with the rules of the Michigan Board of Land Surveyors or by a Decree of a Court of Law; established, re-established, monumented, re-monumented, recovered, found as expressed below:

NOTE: Not more than 4 corners, all in the same town and range, may be recorded on this certificate.

A. Description of original monument and accessories and/or subsequent restoration:

- Original GLO survey by Orange Risdon in March 1827 indicate 1/4 section post set at a distance of 80.00 chains. Witnessed by: 12" Beech N55W 12 links
10" Sugar N89W 19 links
- LCRC on May 31, 1980 by George Young, PS #17640 (L-2, P-669). Found 1/2" re-rod 8" below road surface. Witnessed by: Nail & Cap in 36" Maple, SE 118.61'
Nail & Cap in 24" Maple, SW 35.80'
Nail & Cap in 12" Wood Post, NW 36.20'

(Over)

B. Description of corner evidence found and/or method applied in restoring or reestablishing corner:

Found 1/2" iron rod with yellow cap #18988 3± West of centerline of Chester Road and in centerline of Ash Highway. Found Nail & Tag #18988 (Fluke) in Southwest Corner of Wood Anchor Post NW 35.80 feet and Nail & Tag #18988 in North side stump SW 35.90 feet. Also found P.K. Nail and orange cap in North side of same tree stump adjacent to other Nail & Tag #18988. Measured North 2,639.44 feet to E-4 and South 2,641.50 feet to E-6. Also found small boat spike adjacent to 1/2" iron rod on Southwest side. Excavated 4' x 10' hole at an average depth of 2 feet to hard black clay subsoil. Found no other evidence. Replaced 1/2" iron rod and cap #18988 with standard 3/4" x 24" iron rod with cap #28414 PA 345. This surveyor accepts location of the 1/2" iron and subsequent 3/4" iron as the perpetuated position of the corner based on Flukes work. Performed traverse and measured East 2,642.20 feet to F-5 and 2,639.33 feet to E-4.

C. Description of monument for corner and accessories established to perpetuate locating the position of the corner:

Set 3/4" x 24" iron rod with cap #28414 PA 345, witnessed by:
Nail and Tag #28414 West side of 8" Pine, S 37 deg. E 62.00 feet
Nail and Tag #28414 East side 36" Maple, S 15 deg. W 97.63 feet
Nail and Tag #28414 North side 36" Maple, S 77 deg. W 119.15 feet
Northwest Corner house foundation #3995, S 69 deg. E 234.17 feet



Signed by Maurice H. Mahieu Date 11-29-94
Surveyor's Michigan License No. #28414

FORM APPROVED BY MICHIGAN STATE BOARD OF LAND SURVEYORS, JAN. 28, 1988
REVISED MAY 14, 1994
REVISED JAN. 1995

P.A. 345 EATON COUNTY
PEER APPROVED 11/23/94

(Continued)

LIBER 3 Pg 556

3. Corner referred to in Act 132 survey done by George Young, PS #17640, on June 12, 1980 (L-35, P-197). Found 5/8" rod. Witnesses same as in Liber 2, Page 669.

4. Private note of K. Don Fluke PS #18988 dated June 1, 1987 states: Found very large (old spike) at intersection Ash & Chester Roads;
S 53 deg. W 35.96 - Maple 28"
N 33 deg. W 36.49 - R/R Tie Corner Post
N 57 deg. E 46.51 - Top Center of Tell. Riser
S 80 deg. 87.47 - Maple stump 21"
Set 1/2" rod w/RLS cap #18988 beside it