

SURVEY & REMONUMENTATION

APR 27 1995

FILED
COPY

COMMISSION

LAND CORNER RECORDATION CERTIFICATE
Filing Requirement of Act 74, Mich. P.A. 1970
CHESTER TOWNSHIP

94 DEC -1 AM 9:43

For corners in

EATON

(County)

Located In:

Corner Code #7

- | | | |
|------------------------------------|-----------|-----|
| 1. Public Land Survey | T 3N R 5W | F-5 |
| | T R | |
| | T R | |
| | T R | |
| 2. Property Controlling in Section | S T R | |
| | S T R | |
| 3. Miscellaneous Property In Sec. | S T R | |
| | S T R | |

LINDA M. TWITCHELL
REGISTER OF DEEDS
EATON COUNTY, MICH.

LIBER 3 Pg 563

Register of Deeds Stamp & File Number

4. Lot No. _____, Recorded Plat _____
5. Private Claims _____

	A	B	C	D	E	F	G	H	I	J	K	L	M
2	6		5		4		3		2				
3													
4	7		8		9		10		11		12		
5													
6	18		17		16		15		14		13		
7													
8	19		20		21		22		23		24		
9													
10	30		29		28		27		26		25		
11													
12	31		32		33		34		35		36		
13													

I, Maurice H. Mahieu, in a field survey on October 27, 1994

do hereby certify that under requirements of P.A. 74, Michigan P.A. of 1970, the corner points mentioned in lines 1 and 2 above were in conformance with regulations and rules therefore as required in the current manual of survey instructions of the United States Department of the Interior, Bureau of Land Management or by a decree of a Court of Law and/or that the corner points mentioned in lines 3, 4 and 5 above were in conformance with the rules of the Michigan Board of Land Surveyors or by a Decree of a Court of Law; established, re-established, monumented, re-monumented, recovered, found as expressed below:

NOTE: Not more than 4 corners, all in the same town and range, may be recorded on this certificate.

A. Description of original monument and accessories and/or subsequent restoration:

1. Original GLO survey by Orange Ridson in March 1827 indicate 1/4 post set at an average distance of 39.93 chains on a true line. Witnessed by: 16" Ash, N 38 deg. W 6 links
8" Hickory, S 38 deg. E 26 links


No other evidence found for this corner.

B. Description of corner evidence found and/or method applied in restoring or reestablishing corner:

Excavated 6' x 6' hole at an average depth of 3 feet at the intersection of centerline of Ash Highway and North-South tree line. Found no evidence. Excavated another 6' x 6' hole at an average depth of 3 feet in the centerline of Ash Highway and at the single proportionate measurement position between E-5 and G-5. Found no evidence of a corner. Determined this corner to be lost. Set 3/4" x 24" iron rod with cap #28414 PA 345 at the single proportionate measurement position between E-5 and G-5. Measured West 2,642.20 feet to E-5, and East 2,642.20 feet to G-5. Corner is 9.5 feet West of tree line.

C. Description of monument for corner and accessories established to perpetuate locating the position of the corner:

Set 3/4" x 24" iron rod with cap #28414 PA 345, witnessed by:
Set Nail and Tag #28414 East side 8" Pine, North 54 deg. W 37.03 feet
Set Nail and Tag #28414 East side Utility Pole, N 17 deg. W 26.96 feet
Set Nail and Tag #28414 West side 28" Oak, N 38 deg. E 26.69 feet
Set Nail and Tag #28414 East side Utility Pole, S 17 deg. E 52.61 feet

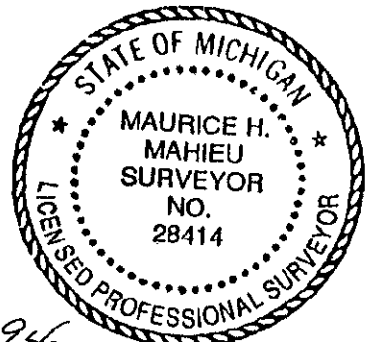

Signed by Maurice H. Mahieu #28414 Date 11-29-94
Surveyor's Michigan License No. _____