

DEC 12 1997

COMMISSION

FILED

Copy

97 AUG 12 PM 12: 37

LAND CORNER RECORDATION CERTIFICATE
Filing Requirement of Act 74, Mich. P.A. 1970

For corners in

<u>EATON</u> (County)	Located In: <u>CHESTER</u>	Corner Code # <u>TOWNSHIP</u>
1. Public Land Survey	<u>T 3N</u> <u>R 5W</u>	<u>F-8</u>
	T _____ R _____	_____
	T _____ R _____	_____
	T _____ R _____	_____
2. Property Controlling in Section	S _____ T _____ R _____	_____
	S _____ T _____ R _____	_____
3. Miscellaneous Property in Sec.	S _____ T _____ R _____	_____
	S _____ T _____ R _____	_____

LINDA M. TWITCHELL
REGISTER OF DEEDS
EATON COUNTY, MICH.

LIBER 3 pg 788

Register of Deeds Stamp & File Number

4. Lot No. _____, Recorded Plat _____
5. Private Claims _____

I, RON HELSEL, in a field survey on APRIL 23, 1997 do hereby certify that under requirements of P.A. 74, Michigan P.A. of 1970, the corner points mentioned in lines 1 and 2 above were in conformance with regulations and rules therefore as required in the current manual of survey instructions of the United States Department of the Interior, Bureau of Land Management or by a decree of a Court of Law and /or that the corner points mentioned in lines 3, 4 and 5 above were in conformance with the rules of the Michigan Board of Land Surveyors or by a Decree of a Court of Law; established, re-established, monumented, re-monumented, recovered, found as expressed below:

1	A	B	C	D	E	F	G	H	I	J	K	L
2		6		5		4		3		2		1
3												
4		7		8		9		10		11		12
5												
6		18		17		16		15		14		13
7												
8		19		20		21		22		23		24
9												
10		30		29		28		27		26		25
11												
12		31		32		33		34		35		36
13												

NOTE: Not more than 4 corners, all in the same town and range, may be recorded on this certificate.

A. Description of original monument and accessories and/or subsequent restoration:
CORNER NOT SET IN ORIGINAL GOVERNMENT SURVEY.


1) DID NOT FIND ANY PUBLIC RECORDS OF COUNTY SURVEY ACTIVITY OR PRIVATE SURVEYS TIED TO THIS CORNER.

B. Description of corner evidence found and/or method applied in restoring or reestablishing corner:

FOUND 1/2" REBAR AND CAP NO. 18988 (K.D. FLUKE), LEANING OUT OF GROUND AT BASE OF FALLEN WOOD ANCHOR POST. FENCES TO THE NORTH, EAST AND SOUTH. EXCAVATED AND FOUND A POINTED STONE 8" BELOW GROUND, 0.2 FEET WEST OF THE 1/2" BAR. ALSO FOUND A CIRCLE OF STONES ENTWINED IN TREE ROOTS AND THE FENCE LINES AROUND THE POINTED STONE. (SURVEYOR CHRISTENSON DID NOT HAVE ANY FLUKE SURVEYS REFERENCED TO THIS CORNER.) TRAVERSE MEASUREMENTS FOUND THE 1/2" BAR POSITIONED 7.12 FEET SOUTH AND 1.27 FEET EAST OF THE INTERSECTION OF THE 1/4 LINES OF SECTION 21. ACCEPTED THE STONE AS A PROBABLE UNRECORDED COUNTY SURVEYOR MARKER FOR THE CORNER. REMOVED 1/2" BAR AND POINTED STONE AND SET A 3/4" X 24" FORM PIN AND CAP STAMPED P.A. 345, P.S. NO. 18994 TO GRADE. LEFT POINTED STONE LYING AT WEST SIDE OF 3/4" BAR.

C. Description of monument for corner and accessories established to perpetuate locating the position of the corner:

3/4" FORM PIN AND CAP AT BASE OF FALLEN WOOD ANCHOR POST
SET NAIL AND TAG NO. 18994 N/SIDE OF 22" BEECH, AZ. 101 DEG., 29.35 FEET
SET NAIL AND TAG NO. 18994 SW/SIDE OF 26" ASH, AZ. 130 DEG., 11.57 FEET (ABOVE FLUKE TAG)
SET NAIL AND TAG NO. 18994 E/SIDE OF 18" BEECH, AZ. 164 DEG., 18.98 FEET
SET NAIL AND TAG NO. 18994 N/SIDE OF 14" OAK, AZ. 270 DEG., 9.80 FEET (ABOVE FLUKE TAG)
SET NAIL AND TAG NO. 18994 E/SIDE OF 12" ASH, AZ. 360 DEG., 27.92 FEET (ABOVE FLUKE TAG)
MEAS. NORTH, 2661.77 FEET TO F-7
MEAS. SOUTH, 2626.98 FEET TO F-9
MEAS. WEST, 2629.34 FEET TO E-8
MEAS. EAST, 2631.77 FEET TO G-8

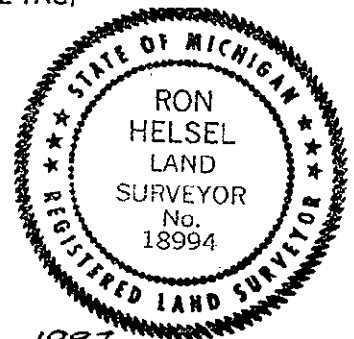

Signed by Ron Helsel Date July 19, 1997
Surveyor's Michigan License No. 18994

P.A. 345 EATON COUNTY
PEER APPROVED 7/22/97 *ML*