

APR 27 1995

COMMISSION

LAND CORNER RECORDATION CERTIFICATE

94 DEC -1 AM 9:43

Filing Requirement of Act 74, Mich. P.A. 1970

CHESTER TOWNSHIP

For corners in

EATON

(County)

Located In:

Corner Code #

- 1. Public Land Survey T3N R 5W G-3
- T R
- T R
- T R
- 2. Property Controlling S T R
- in Section S T R
- 3. Miscellaneous S T R
- Property in Sec. S T R

LINDA M. TWITCHELL
REGISTER OF DEEDS
EATON COUNTY, MICH.

LIBER 3 Pg 568


Register of Deeds Stamp & File Number

- 4. Lot No. _____, Recorded Plat _____
- 5. Private Claims _____

I, Maurice H. Mahieu, in a field survey on October 28, 1994

do hereby certify that under requirements of P.A. 74, Michigan P.A. of 1970, the corner points mentioned in lines 1 and 2 above were in conformance with regulations and rules theretore as required in the current manual of survey instructions of the United States Department of the Interior, Bureau of Land Management or by a decree of a Court of Law and/or that the corner points mentioned in lines 3, 4 and 5 above were in conformance with the rules of the Michigan Board of Land Surveyors or by a Decree of a Court of Law; established, re-established, monumented, re-monumented, recovered, found as expressed below:

NOTE: Not more than 4 corners, all in the same town and range, may be recorded on this certificate.

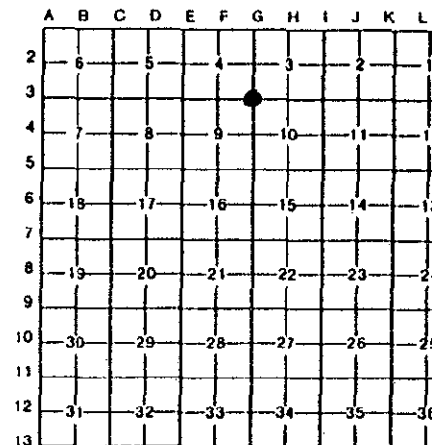

A. Description of original monument and accessories and/or subsequent restoration:

- 1. Original GLO survey by Orange Risdon in March 1827 indicate section post set at a distance of 80.00 chains, Witnessed by: 14" Beech, S83 deg. W 16 links 12" Lynn, N80 deg. E 38 links
- 2. LCRC dated May 17, 1976 in Liber 2, Page 351 by Kay Don Fluke, Land Surveyor #18988, Found 1" bar 12" below bit. surface on Mulliken Road, witnessed by: Utility Pole SE 71.58' 14" Ash SW 78.25' Utility Pole, WNW 78.17'

(Over)

B. Description of corner evidence found and/or method applied in restoring or reestablishing corner:

Found 1/2" x 18" iron rod in monument box 1± East of centerline of Mulliken Road and 1± South of centerline of Bursley Highway. Found Nail and Tag #18988 Southwest side Utility Poles WNW 72.18 feet. Excavated 5' x 6' Hole at an average depth of 3 feet. Found 1" x 21" threaded iron rod with 1 1/2" x 1 1/2" x 1" nut on top. 1" rod found on Southwest side of 1/2" iron rod. 1" rod was found at a depth of 2 feet±. Also found medium size pointed stone on North side of 1" rod at a depth of 2.5 feet. Set standard 3/4" x 24" iron rod with cap #28414 PA 345 in location of pointed stone. Set monument box over 3/4" rod. This surveyor accepted position of stone rather than 1" rod based on the unknown origin of 1" rod. Also felt that the stone is more indicative of the type of monumentation that was set in the area even though there was no County Surveyor's records found. The 3/4" set rod is 0.3' Northeast of found rod. Performed traverse and measured South 2,640.24 feet to G-4, West 2,644.18 feet to F-3 and 2,649.38 feet to G-2.

C. Description of monument for corner and accessories established to perpetuate locating the position of the corner:

Set 3/4" x 24" iron rod with cap #28414 PA 345 in monument box, witnessed by:
Set Nail and Tag #28414 South side Utility Pole, N 77 deg. W 71.62 feet
Set Nail and Tag #28414 South side 8" Hickory, S 45 deg. W 74.49 feet
Set Nail and Tag #28414 North side 18" Ash, S 36 deg. W 77.84 feet
Set Nail and Tag #28414 East side 32" Hickory, N 27 deg. W 116.44 feet



Signed by Maurice H. Mahieu Date 11-29-94
Surveyor's Michigan License No. 28414

(Continued)

LIBER 3 Pg 560

3. Unrecorded survey by Kay Don Fluke PS #18988 dated April 30, 1976, gives no monumentation, but has same witnesses as A-2.