

DEC 16 1995

COMMISSION

FILED

Copy

LAND CORNER RECORDATION CERTIFICATE 96 JUN 11 AM 10:06  
Filing Requirement of Act 74, Mich. P.A. 1970

CHESTER TOWNSHIP

For corners in

EATON  
(County)

Located In: Corner Code ##

- 1. Public Land Survey T 3N R 5W G-7  
T \_\_\_\_\_ R \_\_\_\_\_  
T \_\_\_\_\_ R \_\_\_\_\_  
T \_\_\_\_\_ R \_\_\_\_\_
- 2. Property Controlling S \_\_\_\_\_ T \_\_\_\_\_ R \_\_\_\_\_  
in Section S \_\_\_\_\_ T \_\_\_\_\_ R \_\_\_\_\_
- 3. Miscellaneous S \_\_\_\_\_ T \_\_\_\_\_ R \_\_\_\_\_  
Property in Sec. S \_\_\_\_\_ T \_\_\_\_\_ R \_\_\_\_\_

LINDA M. TWITCHELL  
REGISTER OF DEEDS  
EATON COUNTY, MICH.

LIBER 3 Pg 689

Register of Deeds Stamp & File Number

- 4. Lot No. \_\_\_\_\_, Recorded Plat \_\_\_\_\_
- 5. Private Claims \_\_\_\_\_

A	B	C	D	E	F	G	H	I	J	K	L
2	6	5	4	3	2						
3											
4	7	8	9	10	11						
5											
6	18	17	16	15	14						
7											
8	19	20	21	22	23						
9											
10	30	29	28	27	26						
11											
12	31	32	33	34	35						
13											

I, RON HELSEL, in a field survey on MAY 6, 1996, do hereby certify that under requirements of P.A. 74, Michigan P.A. of 1970, the corner points mentioned in lines 1 and 2 above were in conformance with regulations and rules therefore as required in the current manual of survey instructions of the United States Department of the Interior, Bureau of Land Management or by a decree of a Court of Law and/or that the corner points mentioned in lines 3, 4 and 5 above were in conformance with the rules of the Michigan Board of Land Surveyors or by a Decree of a Court of Law; established, re-established, monumented, re-monumented, recovered, found as expressed below:

NOTE: Not more than 4 corners, all in the same town and range, may be recorded on this certificate.

A. Description of original monument and accessories and/or subsequent restoration:


ORIGINAL MONUMENT: POST SET BY ORANGE RISDON, U.S. DEPUTY SURVEYOR, MARCH, 1827. BEECH 18", N38°E, 9 LINKS  
BEECH 12", S48°W, 53 LINKS

- 1) FROM THE MARGIN OF THE EATON COUNTY G.L.O. NOTES DATED APRIL-22 GVP  
WALNUT S49°W, 57 3/4'  
SU MAPLE N60°E, 69 3/4'  
SE COR. CHURCH TOWER N42 1/2°W, 95'
- 2) EATON CO. ROAD COMM. MAP WITNESSED THIS CORNER AS A STONE  
SE COR. OF CHURCH TOWER NW 95'0" (FOUND)  
20" WALNUT SW 57' (FOUND STUMP)

"CONTINUED ON BACK"

B. Description of corner evidence found and/or method applied in restoring or reestablishing corner:

FOUND A 3/4" AXLE SHAFT IN A MON. BOX 2.5' EAST CENTERLINE MULLIKEN RD. & CENTERLINE OF GRESHAM RD., 10" DEEP. EXCAVATED AND FOUND POINTED STONE ON SOUTH SIDE OF AXLE SHAFT. COULD NOT REMOVE THE SHAFT AFTER EXCAVATING ALMOST 3' FURTHER. ACCEPTED THE POSITION OF THE SHAFT AS THE BEST EVIDENCE FOR THE CORNER. DROVE A 3/4" X 24" FORM PIN ANGLING WESTERLY WITH TOP OVER THE AXLE SHAFT. PLACED CAP LABELED P.A. 345, P.S. NO. 18994.

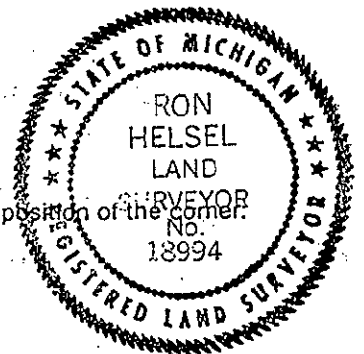

C. Description of monument for corner and accessories established to perpetuate locating the position of the corner:

3/4" X 24" PIN & CAP OVER AXLE SHAFT  
SW CORNER OF HOUSE FOUNDATION AZ. 41°, 85.11'  
SE CORNER OF CHURCH BELL TOWER AZ. 323°, 95'±  
NE CORNER OF HOUSE FOUNDATION AZ. 237°, 74.99'  
SET NAIL AND TAG NO. 18994 N/SIDE 12" ASH, AZ. 251°, 44.87'  
SET NAIL AND TAG NO. 18994 NE/SIDE 24" MAPLE, AZ. 131°, 91.53'  
SET NAIL AND TAG NO. 18994 W/SIDE 22" ASH, AZ. 36°, 63.51'

Signed by Ron Helsel Date MAY 22, 1996

Surveyor's Michigan License No. 18994 P.A. 345 EATON COUNTY

PEER APPROVED 5/23/96 RL

## "A" CONTINUED

- 3) A SURVEY BY LESLIE H. BELKNAP R.C.E. #31, DATED MAY 1, 1960 CALLED FOR "IRON IN PLACE" WITH NO WITNESSES.
- 4) A L.C.R.C. BY RON HELSEL PS #18994, DATED MARCH 20, 1973 AND RECORDED IN LIBER 1, PAGE 248, CALLED FOR AN AXLE SHAFT 2.5' EAST CENTERLINE OF MULLIKEN ROAD.  
SE CORNER OF CHURCH N45°W, 96.35' (FOUND) UNMEASURABLE  
SW CORNER OF HOUSE N35°E, 85.29' (FOUND)  
NE CORNER OF HOUSE S30°W, 75.02' (FOUND)
- 5) A SURVEY BY R. HELSEL DATED MARCH 20, 1973, WAS RECORDED IN LIBER 1, PG. 314, REVISED AND RE-RECORDED IN LIBER 1, PG. 356 AND LIBER 1, PG. 355 AND RE-RECORDED IN LIBER 1, PG. 437 CALLED FOR THE SAME WITNESSES AS 4-A ABOVE.
- 6) A SURVEY BY ROBERT G. REED P.S. #19004, DATED 6-28-92 AND RECORDED IN LIBER 3, PG. 457 CALLED FOR A "3/4" BAR RAISED TO SURFACE WITH SPIKE".  
SE CORNER CHURCH BUILDING NW 96.2' (FOUND)  
NE CORNER OF HOUSE SW 74.6' (FOUND)  
21" MAPLE ENE 83.7' (GONE)
- 7) A SURVEY BY ROBERT G. REED, DATED 8-18-87, RECORDED IN LIBER 4, PG. 346 CALLED FOR THE "3/4" BAR RAISED TO SURFACE WITH SPIKE" AND THE SAME WITNESSES AS THE L.C.R.C. IN (4-A) ABOVE.
- 8) DID NOT FIND FURTHER MENTION OF THIS CORNER IN PUBLIC OR PRIVATE RECORDS.