

1993

EATON COUNTY REMONUMENTATION

FILED

COMMISSION

LAND CORNER RECORDATION CERTIFICATE

Filing Requirement of Act 74, Mich. P.A. 1970

For corners in

93 SEP 15 PM 12: 22

EATON (County) Located In: VERMONTVILLE TOWNSHIP Corner Code: B-3

1. Public Land Survey	T	3N	R	6W	B-3
	T		R		
	T		R		
	T		R		
2. Property Controlling in Section	S		T	R	
	S		T	R	
3. Miscellaneous Property in Sec.	S		T	R	
	S		T	R	
4. Lot No. _____, Recorded Plat _____					
5. Private Claims _____					


LINDA M. TWITCHELL REGISTER OF DEEDS EATON COUNTY, MICH.

LIBER 3 PAGE 237

Register of Deeds Stamp & File Number

I, **BRIAN REYNOLDS**, in a field survey on **July 1**, 19**93**, do hereby certify that under requirements of P.A. 74, Michigan P.A. of 1970, the corner points mentioned in lines 1 and 2 above were in conformance with regulations and rules therefore as required in the current manual of survey instructions of the United States Department of the Interior, Bureau of Land Management or by a decree of a Court of Law and/or that the corner points mentioned in lines 3, 4 and 5 above were in conformance with the rules of the Michigan Board of Land Surveyors or by a Decree of a Court of Law; established, re-established, monumented, re-monumented, recovered, found as expressed below:

NOTE: Not more than 4 corners, all in the same town and range, may be recorded on this certificate.

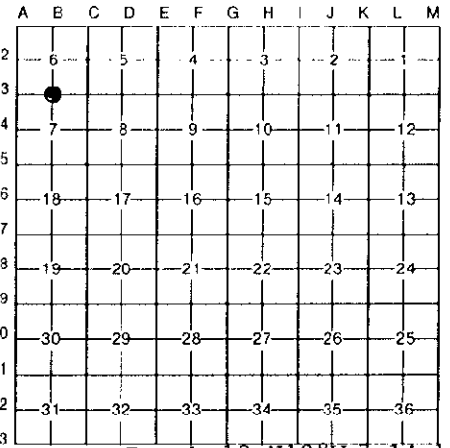

A. Description of original monument and accessories and/or subsequent restoration:
 Corner established by General Land Office Deputy Surveyor Orange Risdon Do 10 S22°E 58 links A survey by A. N. Bateman, Eaton County Surveyor, dated April, 1893, notes read "found old Gov't stake and witnesses to it." Survey is of Section 7, recorded in Book 3, Page 32. Another survey of Section 7 by Wm. H. Simpson, County Surveyor, dated 1872, recorded in book 1, pp 152-153, "F. O. B. T. & Stake, S. Stake," My interpretation, "found old bearing trees and stake, set stake."

Survey by Nederveld (no date) found 1" pipe 3' long (bent) found where bottom went into ground and reset. Falls in C/L "X" on fences to N,S,E,&W. 0.3' So. of SE side 6" dia. post. (Nederveld witnesses on reverse side of this form)

B. Description of corner evidence found and/or method applied in restoring or reestablishing corner:

Found pipe and witnesses as described by Nederveld. The pipe being consistent with occupation in all cardinal directions and finding no evidence to the contrary, accepted the pipe as a careful and faithful perpetuation of the position of the original corner.

C. Description of monument for corner and accessories established to perpetuate locating the position of the corner:

Witnesses to 1" pipe:

- Set 40d spike and tag in SW face of 12" Ash N50°E 5.60'
 - Set 40d spike and tag in NW face of 6" Hickory S25°E 11.61'
 - Set 40d spike and tag in NE face of 6" Locust S32°W 15.42'
 - Set 40d spike and tag in South face of 6" Hickory N82°W 17.55'
 - Set 40d spike and tag in East face of 24" Locust N05°W 21.55'
- Note: Witness tags are round orange plastic discs inscribed "REYNOLDS 31602."

Signed by *[Signature]*

Date July 7, 1993

Surveyor's Michigan License No. 31602

Filed 9/17/93

CONTINUATION OF PART "A" (NEDERVELD WITNESSES)

LIBER 3 PAGE 238

Nail in SE side 6" tree N45°E 5.60 feet

Nail in SW side 4" tree S45°E 11.65 feet

Nail in S side 6" tree S90°W 17.52 feet

Nail in E side 18" tree N10°W 21.56 feet

Gordon Nederveld, Professional Surveyor #21272)