

FILED

copy

FEB 22 1996

EATON COUNTY REMONUMENTATION

COMMISSIONER

LAND CORNER RECORDATION CERTIFICATE

95 DEC 26 PM 2:28

Filing Requirement of Act 74, Mich. P.A. 1970

For corners in

EATON

(County)

Located In:

Corner Code #

1. Public Land Survey
VERMONTVILLE TWP.
NORTH 1/4 COR. SEC. 5

T 3N R 6W

D-1

T R

T R

T R

T R

2. Property Controlling
in Section

S T R

S T R

3. Miscellaneous
Property in Sec.

S T R

S T R

4. Lot No. _____, Recorded Plat _____
5. Private Claims _____

LINDA M. TWITCHELL
REGISTER OF DEEDS
EATON COUNTY, MICH.

h.3 pg 658

Register of Deeds Stamp & File Number

I, **BRIAN REYNOLDS**, in a field survey on **21 DECEMBER**, 19**95**

do hereby certify that under requirements of P.A. 74, Michigan P.A. of 1970, the corner points mentioned in lines 1 and 2 above were in conformance with regulations and rules therefore as required in the current manual of survey instructions of the United States Department of the Interior, Bureau of Land Management or by a decree of a Court of Law and/or that the corner points mentioned in lines 3, 4 and 5 above were in conformance with the rules of the Michigan Board of Land Surveyors or by a Decree of a Court of Law; established, re-established, monumented, re-monumented, recovered, found as expressed below:

NOTE: Not more than 4 corners, all in the same town and range, may be recorded on this certificate.

	A	B	C	D	E	F	G	H	I	J	K	L	M
2	6		5		4		3		2		1		
3													
4	7		8		9		10		11		12		
5													
6	18		17		16		15		14		13		
7													
8	19		20		21		22		23		24		
9													
10	30		29		28		27		26		25		
11													
12	31		32		33		34		35		36		

A. Description of original monument and accessories and/or subsequent restoration:

- 1. GENERAL LAND OFFICE: CORNER NOT SET BY GENERAL LAND OFFICE SURVEY
- 2. COUNTY SURVEYOR OSCAR C. CHURCH IMPLIES A BREAKDOWN OF SECTION 5 NO WITNESSES, 26 MAY 1876 SURVEY OF SECTION 5, VOL. 2, P. 30

NO OTHER HISTORICAL DATA, PUBLIC OR PRIVATE, COULD BE FOUND FOR THIS CORNER.

B. Description of corner evidence found and/or method applied in restoring or reestablishing corner:


NO LOCAL EVIDENCE OF CORNER COULD BE FOUND. NO EVIDENCE OF OCCUPATION LINE EXISTS FOR NORTH-SOUTH 1/4 LINE A NORTH LINE OF SECTION. TRAVERSED ENTIRE SECTION 5, TIED IN OCCUPATION LINES AND CORNERS. A LINE FROM CENTER OF SECTION 5 OCCUPATION PROJECTED THROUGH OCCUPATION CORNER 1/4 MILE NORTH INTERSECTS RESTORED TOWN LINE VERY CLOSE TO MID-POINT OF LINE FROM RESTORED C-1 TO RESTORED E-1. SET STANDARD EATON COUNTY REMON IRON AND CAP AT INTERSECTION OF PROJECTED OCCUPATION LINE AND RESTORED TOWN LINE.

TO C-1 N89°32'13"W 2669.40'
 TO C-2 S0°26'43"W 2669.61'
 TO E-1 S89°32'12"E 2668.93'

C. Description of monument for corner and accessories established to perpetuate locating the position of the corner:

SET STANDARD EATON COUNTY REMON IRON AND PLASTIC CAP INSCRIBED "PA 345 31602" IN MON BOX

SET 20d NAIL WITH PLASTIC TAG IN WEST SIDE OF A 12" CHERRY N35°W 61.46'
 SET 20d NAIL WITH PLASTIC TAG IN WEST SIDE OF A UTILITY POLE N17°E 118.38'
 SET 20d NAIL WITH PLASTIC TAG IN EAST SIDE OF A UTILITY POLE N53°W 191.54'
 SET 20d NAIL WITH PLASTIC TAG IN SOUTH SIDE OF A UTILITY POLE N70°E 290.40'
 D-13 T4N, R6W, SUNFIELD TOWNSHIP, N89°32'W 19.37'
 CENTERLINE EAST-WEST BITUMINOUS ROADWAY (KELLY HIGHWAY) NORTH 8'+/-
 TREE LINE (OCCUPATION) NORTH LIES WEST 35'+/-

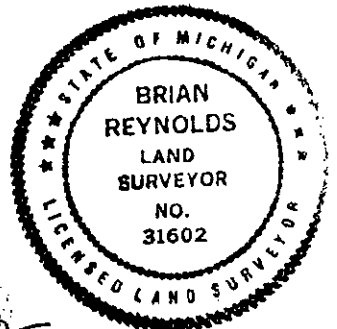

Signed by *[Signature]*

Date 12/21/95

Surveyor's Michigan License No. 31602

P.A. 345 EATON COUNTY FORM APPROVED BY MICHIGAN STATE BOARD OF LAND SURVEYORS, JAN. 28, 1971

PEER APPROVED 9/28/95 m

REVISED MAY 14, 1975
REVISED JAN., 1983