

LAND CORNER RECORDATION CERTIFICATE  
Filing Requirement of Act 74, Mich. P.A. 1970

95 NOV 21 PM 12: 25

For corners in

<u>EATON</u> (County)	Located in:	Corner Code #
<b>VERMONTVILLE TOWNSHIP</b>		
1. Public Land Survey	T <u>3N</u> R <u>6W</u>	<u>J-9</u>
	T _____ R _____	_____
	T _____ R _____	_____
	T _____ R _____	_____
2. Property Controlling in Section	S _____ T _____ R _____	_____
	S _____ T _____ R _____	_____
3. Miscellaneous Property in Sec.	S _____ T _____ R _____	_____
	S _____ T _____ R _____	_____

LINDA M. TWITCHELL  
REGISTER OF DEEDS  
EATON COUNTY, MICH.

LIBER 3 PAGE 624

Register of Deeds Stamp & File Number

- 4. Lot No. \_\_\_\_\_, Recorded Plat \_\_\_\_\_
- 5. Private Claims \_\_\_\_\_

A	B	C	D	E	F	G	H	I	J	K	L	M
2	6	5	4	3	2	1						
3												
4	7	8	9	10	11	12						
5												
6	13	14	15	16	17	18						
7												
8	19	20	21	22	23	24						
9												
10	30	29	28	27	26	25						
11												
12	31	32	33	34	35	36						

I, RONALD L. ENGER, in a field survey on SEPTEMBER 15, 19 95, do hereby certify that under requirements of P.A. 74, Michigan P.A. of 1970, the corner points mentioned in lines 1 and 2 above were in conformance with regulations and rules therefore as required in the current manual of survey instructions of the United States Department of the Interior, Bureau of Land Management or by a decree of a Court of Law and/or that the corner points mentioned in lines 3, 4 and 5 above were in conformance with the rules of the Michigan Board of Land Surveyors or by a Decree of a Court of Law; established, re-established, monumented, re-monumented, recovered, found as expressed below:

NOTE: Not more than 4 corners, all in the same town and range, may be recorded on this certificate.


A. Description of original monument and accessories and/or subsequent restoration:

1. POST SET IN ORIGINAL GOVERNMENT SURVEY BY ORANGE RISDON, DEPUTY SURVEYOR, IN MARCH 1827 WITH THE FOLLOWING WITNESSES:  
ELM 10" N30°E 10  
SUGAR 9" S37°W 32

CONTINUED ON BACK

B. Description of corner evidence found and/or method applied in restoring or reestablishing corner:

EXCAVATED 2' X 2' HOLE TO A DEPTH OF 3' INTO NATURAL GROUND. FOUND NO EVIDENCE OF CORNER. ACCEPTED R.R. SPIKE AS PERPETUATION OF CORNER BASED ON EXISTENCE OF 1920 WITNESSES, WHICH AGREE WITH LOCATION OF R.R. SPIKE AND ACCORDINGLY SET STANDARD MARKER FOR PA 345 REMONUMENTATION IN EATON COUNTY IN IT'S PLACE.

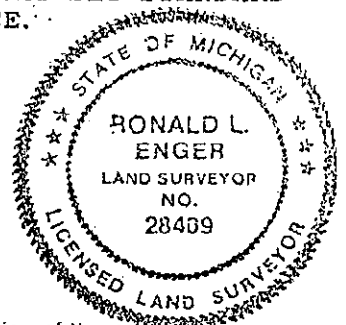

C. Description of monument for corner and accessories established to perpetuate locating the position of the corner:

J-9 T3N R6W  
3/4" DIAMETER X 24" LONG SMOOTH STEEL BAR AND CAP IMPRINTED "PA345 PS 28409" IN MONUMENT BOX.  
SET 20D GALV. SPIKE & TAG PS 28409 IN SOUTH SIDE OF 36" MAPLE, 70° NAZ., 86.30'  
SET 20D GALV. SPIKE & TAG PS 28409 IN NORTH SIDE OF 10" MAPLE, 125° NAZ., 60.87'  
SET 20D GALV. SPIKE & TAG PS 28409 IN NORTH SIDE OF 8" MULTIPLE-TRUNK MAPLE, 110° NAZ., 87.49'  
ANCIENT ANCHOR POST, 180° NAZ., 32.3'  
SET 20D GALV. SPIKE & TAG PS 28409 IN WEST SIDE OF R.R. TIE FENCE POST, 0° NAZ., 32.88'  
CORNER IS 1' NORTH OF CENTERLINE OF VERMONTVILLE HIGHWAY ON FENCELINE TO NORTH AND SOUTH.

Signed by RE Date SEPTEMBER 28, 1995  
Surveyor's Michigan License No. 28409

J-9 T3N R6W  
PART A CONTINUED

2. J.H. GIBBONS, COUNTY SURVEYOR, USED CORNER IN A SURVEY IN FEBRUARY 1869 AS A STAKE AND CROCKERY.

3. MARGINAL NOTE ECRC COPY GLO NOTES:

STONE

MAPLE NE 85.1'(FOUND)

ANCHOR POST S 31.3'(FOUND)

HARVEY WILLIAMS 1920

4. EATON COUNTY ROAD COMMISSION GRID MAP, SAME MONUMENT AND WITNESSES AS ITEM 3.

5. JOHN SELLEK, LS 2585, RECORDED CORNER IN LIBER 2 OF CORNERS, PAGE 643, IN DECEMBER 1979 AS A SET R.R. SPIKE FROM HAW (H.A. WILLIAMS) ANCHOR POST WITNESS OF 1920

P.K. NAIL IN ANCHOR POST S 32.3' (FOUND)

P.K. NAIL IN MULTIPLE-TRUNK MAPLE S70°E 87.8'

P.K. NAIL IN 30" MAPLE N70°E 86.3' (FOUND)

CENTERLINE VERMONTVILLE HIGHWAY S 1.6'

6. JOHN SELLEK REPORTED USING CORNER IN A SURVEY RECORDED IN LIBER 3 OF SURVEYS, PAGE 69, IN DECEMBER 1979 WITH SAME MONUMENT AND WITNESSES AS ITEM 5.