

DEC 1 6 1996

FILED
Copy

COMMISSION

LAND CORNER RECORDATION CERTIFICATE
Filing Requirement of Act 74, Mich. P.A. 1970

96 NOV -7 PM 3:15

For corners in

EATON	Located In:	Corner Code #/
(County) VERMONTVILLE TOWNSHIP	3N 6W	K-7
1. Public Land Survey	T ___ R ___	_____
	T ___ R ___	_____
	T ___ R ___	_____
	T ___ R ___	_____
2. Property Controlling in Section	S ___ T ___ R ___	_____
	S ___ T ___ R ___	_____
3. Miscellaneous Property in Sec.	S ___ T ___ R ___	_____
	S ___ T ___ R ___	_____
4. Lot No. _____, Recorded Plat _____		
5. Private Claims _____		

LINDA M. TWITCHELL
REGISTER OF DEEDS
EATON COUNTY, MICH.

L3 pg 745

Register of Deeds Stamp & File Number

I, DAVID L. CLIFFORD in a field survey on OCTOBER 3, 1996, do hereby certify that under requirements of P.A. 74, Michigan P.A. of 1970, the corner points mentioned in lines 1 and 2 above were in conformance with regulations and rules therefore as required in the current manual of survey instructions of the United States Department of the Interior, Bureau of Land Management or by a decree of a Court of Law and/or that the corner points mentioned in lines 3, 4 and 5 above were in conformance with the rules of the Michigan Board of Land Surveyors or by a Decree of a Court of Law; established, re-established, monumented, re-monumented, recovered, found as expressed below:

A	B	C	D	E	F	G	H	I	J	K	L	M
2	6	5	4	3	2	1						
3												
4	7	8	9	10	11	12						
5												
6	18	17	16	15	14	13						
7												
8	19	20	21	22	23	24						
9												
10	30	29	28	27	26	25						
11												
12	31	32	33	34	35	36						
13												

NOTE: Not more than 4 corners, all in the same town and range, may be recorded on this certificate.

A. Description of original monument and accessories and/or subsequent restoration:


1. POST SET IN ORIGINAL GOVERNMENT SURVEY BY ORANGE RISDON, DEPUTY SURVEYOR IN MARCH 1827. WITNESSES: BEECH 10" S65°W 14LKS. BEECH 12" N65°E 7LKS.
 2. J.H. GIBBONS USED CORNER IN FEBRUARY 1869 AS A STONE AND CROCKERY
- CONTINUED ON BACK

B. Description of corner evidence found and/or method applied in restoring or reestablishing corner:

SEARCHED AT APPARENT LOCATION OF CORNER AND 1" IRON PIPE 18" DEEP AT CENTERLINE INTERSECTION GRESHAM HIGHWAY AND SHAYTOWN ROAD. EXCAVATED 2'x 2' HOLE 2' DEEP AND FOUND NOTHING MORE. RETURNED WITH A BACKHOE ON SEPTEMBER 30, 1996 AND DUG 7' X 7' HOLE 3 FEET DEEP INTO NATURAL GROUND AND FOUND NO OTHER EVIDENCE OF CORNER. ACCEPTED 1" PIPE AS PERPETUATION OF CORNER AND SET STANDARD EATON COUNTY REMONUMENTATION MONUMENT ON TOP OF IT. MEASURED 2633.79 FEET EAST TO L-7. MEASURED SOUTH 2648.32 FEET TO K-8.

C. Description of monument for corner and accessories established to perpetuate locating the position of the corner:

- K-7 T3N R6W
 3/4" DIAMETER X 24" LONG SMOOTH STEEL BAR AND ORANGE PLASTIC CAP IMPRINTED "PA 345 PS 25837" AT CENTERLINE INTERSECTION GRESHAM HIGHWAY AND SHAYTOWN ROAD
- NAZ 228° NAIL AND TAG 28409 N. SIDE 37" MAPLE 39.75'
 - NAZ 198° NAIL AND TAG 28409 E. SIDE 8" OAK 106.95'
 - NAZ 256° NAIL AND TAG 28409 N. SIDE 35" MAPLE 94.75'
 - NAZ 341° NAIL AND TAG 28409 SW SIDE POWER POLE 74.25'
 - NAZ 31° NAIL AND TAG 25837 W. SIDE 8" CEDAR 71.75'

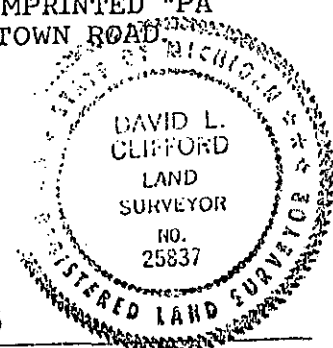

Signed by David L. Clifford Date OCTOBER 16, 1996

Surveyor's Michigan License No. 25837

L 3 P 9746

PART A CONTINUED
K-7 T3N R6W

3. FRED WHITE RLS 12034 RECORDED CORNER IN LIBER 1 OF CORNERS PAGE 205 IN FEBRUARY 1973 AS A FOUND 1" IRON PIPE 6" BELOW GRAVEL AT INTERSECTION GRESHAM HIGHWAY AND SHAYTOWN ROAD.

28" MAPLE S68°W 64.39'

32" MAPLE S45°W 41.14'

CENTERLINE ANCHOR POST N43°W 33.98'

POWER POLE N38°W 73.79'