

SURVEY & REMONUMENTATION

DEC 16 1996

COMMISSION

LAND CORNER RECORDATION CERTIFICATE
 Filing Requirement of Act 74, Mich. P.A. 1970

FILED
 copy

96 NOV -7 PM 3:14

For corners in

<u>EATON</u>	Located In:		Corner Code #
(County)	3N	6W	L-7
1. Public Land Survey	T	R	
	T	R	
	T	R	
	T	R	
2. Property Controlling in Section	S	T	R
	S	T	R
3. Miscellaneous Property in Sec.	S	T	R
	S	T	R

LINDA M. TWITCHELL
 REGISTER OF DEEDS
 EATON COUNTY, MICH.
 L3 Page 742
 Register of Deeds Stamp & File Number

4. Lot No. _____, Recorded Plat _____
 5. Private Claims _____

	A	B	C	D	E	F	G	H	I	J	K	L	M
2	6		5		4		3		2		1		
3													
4	7		8		9		10		11		12		
5													
6	18		17		16		15		14		13		
7													
8	19		20		21		22		23		24		
9													
10	30		29		28		27		26		25		
11													
12	31		32		33		34		35		36		
13													

I, DAVID L. CLIFFORD, in a field survey on OCTOBER 3, 1996

do hereby certify that under requirements of P.A. 74, Michigan P.A. of 1970, the corner points mentioned in lines 1 and 2 above were in conformance with regulations and rules therefore as required in the current manual of survey instructions of the United States Department of the Interior, Bureau of Land Management or by a decree of a Court of Law and/or that the corner points mentioned in lines 3, 4 and 5 above were in conformance with the rules of the Michigan Board of Land Surveyors or by a Decree of a Court of Law; established, re-established, monumented, re-monumented, recovered, found as expressed below:

NOTE: Not more than 4 corners, all in the same town and range, may be recorded on this certificate.

A. Description of original monument and accessories and/or subsequent restoration:


1. POST SET IN ORIGINAL GOVERNMENT SURVEY BY ORANGE RISDON, DEPUTY SURVEYOR IN MARCH 1827. WITNESSES: ELM 12" N52°E 21LKS. SUGAR 18" S67°W 33LKS.
2. J.H. GIBBONS USED CORNER IN MAY 1868 AS A STAKE WITH 4 SMALL STONES AROUND IT.

B. Description of corner evidence found and/or method applied in restoring or reestablishing corner:

SEARCHED AT APPARENT LOCATION OF CORNER ON CENTERLINE GRESHAM HIGHWAY OPPOSITE FENCELINE TO SOUTH AND GOT NO MAGNETIC READINGS ANY WHERE IN VICINITY. EXCAVATED 12'x 18' HOLE 4' DEEP WITH A BACKHOE INTO NATURAL GROUND AND FOUND A FEW PIECES OF BROKEN CROCKERY ON CENTERLINE GRESHAM HIGHWAY. TRAVERSED ALL OF SECTION 24 AND DETERMINED THAT CORNER WAS OBLITERATED AND SET STANDARD EATON COUNTY REMONUMENTATION MONUMENT ON CENTERLINE OF GRESHAM HIGHWAY ON FENCE LINE TO SOUTH. CORNER IS IN AREA WHERE BROKEN CROCKERY WAS FOUND. MEASURED WEST TO K-7 2633.79 FEET AND EAST TO M-7 2629.34 FEET.

C. Description of monument for corner and accessories established to perpetuate locating the position of the corner:

- K-9 T3N R6W
 3/4" DIAMETER X 24" LONG SMOOTH STEEL BAR AND ORANGE PLASTIC CAP IMPRINTED "PA 345 PS 25837" ON CENTERLINE GRESHAM HIGHWAY AT FENCELINE TO SOUTH.
- NAZ 240° NAIL AND TAG 25837 S. SIDE 10" MAPLE 56.45'
 - NAZ 263° NAIL AND TAG 25837 N. SIDE 6" HICK. 114.45'
 - NAZ 68° NAIL AND TAG 25837 S. SIDE 14" MAPLE 74.10'
 - NAZ 183° NAIL AND TAG 25837 W. SIDE RR TIE FENCE POST 36.50'
 - NAZ 143° NAIL AND TAG 25837 W. SIDE 14" HICK. 38.38'
 - NAZ 185° TRAV. POINT VT3-40-34 (1/2" BAR&CAP) 9.38'

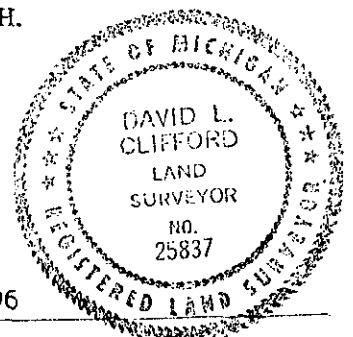

Signed by David L. Clifford Date OCTOBER 16, 1996

Surveyor's Michigan License No. 25837 P.A. 345 EATON COUNTY FORM APPROVED BY MICHIGAN STATE BOARD OF LAND SURVEYORS, JAN. 29, 1971
 PEER APPROVED 10/17/96 REVISED MAY 14, 1975
 REVISED JAN., 1983