

SURVEY & REMONUMENTATION

DEC 16 1996

COMMISSION

LAND CORNER RECORDATION CERTIFICATE
Filing Requirement of Act 74, Mich. P.A. 1970

For corners in

96 NOV -7 PM 3: 14

EATON

Located In:

Corner Code -#

(County)

VERMONTVILLE TOWNSHIP

3N 6W

M-7

- | | | | |
|------------------------------------|---|---|-------|
| 1. Public Land Survey | T | R | _____ |
| | T | R | _____ |
| | T | R | _____ |
| | T | R | _____ |
| 2. Property Controlling in Section | S | T | R |
| | S | T | R |
| 3. Miscellaneous Property in Sec. | S | T | R |
| | S | T | R |

LINDA M. TWITCHELL
REGISTER OF DEEDS
EATON COUNTY, MICH.

L3 pg 741

Register of Deeds Stamp & File Number

4. Lot No. _____, Recorded Plat _____
5. Private Claims _____

	A	B	C	D	E	F	G	H	I	J	K	L	M
2	6	5	4	3	2	1							
3													
4	7	8	9	10	11	12							
5													
6	18	17	16	15	14	13							
7													
8	19	20	21	22	23	24							
9													
10	30	29	28	27	26	25							
11													
12	31	32	33	34	35	36							
13													

I, DAVID L. CLIFFORD, in a field survey on OCTOBER 3, 1996, do hereby certify that under requirements of P.A. 74, Michigan P.A. of 1970, the corner points mentioned in lines 1 and 2 above were in conformance with regulations and rules therefore as required in the current manual of survey instructions of the United States Department of the Interior, Bureau of Land Management or by a decree of a Court of Law and/or that the corner points mentioned in lines 3, 4 and 5 above were in conformance with the rules of the Michigan Board of Land Surveyors or by a Decree of a Court of Law; established, re-established, monumented, re-monumented, recovered, found as expressed below:

NOTE: Not more than 4 corners, all in the same town and range, may be recorded on this certificate.

A. Description of original monument and accessories and/or subsequent restoration:


1. POST SET IN ORIGINAL GOVERNMENT SURVEY BY LUCIUS LYON, DEPUTY SURVEYOR IN FEBRUARY 1826. WITNESSES: W.O. 18" S32°W 23LKS. ASH 14" N43°W 26LKS.
2. ORIGINAL POST AT A-7 T3N R5W SET BY ORANGE RISDON DEPUTY SURVEYOR 20 LINKS (13.2') SOUTH OF M-7 IN MARCH 1827. WITNESSES: W. MAPLE 8" N59°E 15'. ELM 13" S45°E 46'.
3. THORNAPPLE RIVER DRAIN NOTES (MORRELL NEWCOMB, COUNTY SURVEYOR, 1898) CALL FOR CORNER LYING 66' W OF DRAIN.

B. Description of corner evidence found and/or method applied in restoring or reestablishing corner:

SEARCHED AT APPARENT LOCATION OF CORNER 66' WEST OF CENTERLINE OF THORNAPPLE RIVER DRAIN. NO OCCUPATION TO NORTH OR SOUTH. TRAVERSED ALL OF SEC. 24, T3N, R6W. WOLVERINE ENG. TRAVERSED ALL OF SEC. 19, T3N, R5W AND 1/2 MILE NORTH OF M-7 TO OCCUPATION AT M-6 AND A-6. DID NOT EXCAVATE BECAUSE OF 10' OF ROAD FILL FOR BRIDGE. SET CORNER AT INTERSECTION OF STANDARD LINE (AS DETERMINED BY M-8 AND M-9) AND NORTH SECTION LINE (AS DETERMINED BY K-7 AND L-7). MEASURED WEST 2629.34 FEET TO L-7. MEASURED SOUTH 2648.34 FEET TO M-8. MEASURED NORTH 2649.0 FEET NORTH TO OCCUPATION AT M-6. STANDARD LINE IF EXTENDED 1/2 MILE NORTH FALLS IN CENTER OF ABANDONED NORTH-SOUTH ROAD 1/2 WAY BETWEEN ROAD FENCES. CORNER FALLS 66 FEET WEST OF CENTERLINE THORNAPPLE RIVER. BELIEVE THAT LOCATION OF CORNER IS VERY CLOSE TO POSITION THAT LUCIUS LYON ESTABLISHED IN 1826. SET STANDARD EATON COUNTY REMONUMENTATION MONUMENT.

C. Description of monument for corner and accessories established to perpetuate locating the position of the corner:

- M-7 T3N R6W
 3/4" DIAMETER X 24" LONG SMOOTH STEEL BAR AND ORANGE PLASTIC CAP IMPRINTED "PA 345 PS 25837" 4' NORTH OF CENTERLINE GRESHAM HWY.
 NAZ 80° NW CORNER W ABUTMENT BRIDGE, 34.77'
 NAZ 120° SW CORNER W ABUTMENT BRIDGE, 37.01'
 NAZ 157° NAIL AND TAG 25837 NE SIDE 28" OAK, 39.10'
 NAZ 250° NAIL AND TAG 25837 N. SIDE 18" HACKBERRY, 60.02'
 NAZ 260° NAIL AND TAG 25837 N. SIDE 30" HACKBERRY, 117.26'
 NAZ 344° NAIL AND TAG 25837 E. SIDE 18" ASH, 28.46'
 NAZ 185° 3/4" STEEL BAR (A-7 T3N, R5W), 13.20'

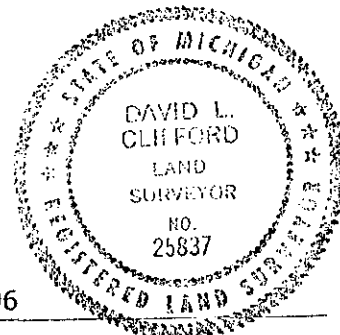

Signed by David L. Clifford Date OCTOBER 16, 1996

Surveyor's Michigan License No. 25837 P.A. 345 EATON COUNTY FORM APPROVED BY MICHIGAN STATE BOARD OF LAND SURVEYORS, JAN. 28, 1977
 REVISÉ MAY 14, 1975
 REVISÉ JAN., 1983

PEER APPROVED 10/17/96 MC