

DEC 12 1997

COMMISSION

FILED

copy

Delta Township

LAND CORNER RECORDATION CERTIFICATE
Filing Requirement of Act 74, Mich. P.A. 1970

97 DEC -5 AM 10:17

For corners in

| Eaton (County) | Located In: | Corner Code # |
|---------------------------------------|-------------------------|---------------|
| 1. Public Land Survey | T <u>4N</u> R <u>3W</u> | <u>A-7</u> |
| | T ___ R ___ | _____ |
| | T ___ R ___ | _____ |
| | T ___ R ___ | _____ |
| 2. Property Controlling in Section | S ___ T ___ R ___ | _____ |
| | S ___ T ___ R ___ | _____ |
| 3. Miscellaneous Property in Sec. | S ___ T ___ R ___ | _____ |
| | S ___ T ___ R ___ | _____ |

LINDA M. TWITCHELL
REGISTER OF DEEDS
EATON COUNTY, MICH.

LIBER 3 PAGE 878

Register of Deeds Stamp & File Number

4. Lot No. _____, Recorded Plat _____
5. Private Claims _____

I, Larry A. Bryan, in a field survey on Sept 15&16, 1997 do hereby state that under requirements of P.A. 74, Michigan P.A. of 1970, the corner points mentioned in lines 1 and 2 above were in conformance with regulations and rules therefore as required in the current manual of survey instructions of the United States Department of the Interior, Bureau of Land Management or by a decree of a Court of Law and /or that the corner points mentioned in lines 3, 4 and 5 above were in conformance with the rules of the Michigan Board of Land Surveyors or by a Decree of a Court of Law; established, re-established, monumented, recovered, found as expressed below:

NOTE: Not more than 2 corners, all in the same town and range, may be recorded on this certificate.

| | | | | | | | | | | | | | |
|----|----|---|----|---|----|---|----|---|----|---|----|---|---|
| | A | B | C | D | E | F | G | H | I | J | K | L | M |
| 1 | | | | | | | | | | | | | |
| 2 | 6 | | 5 | | 4 | | 3 | | 2 | | 1 | | |
| 3 | | | | | | | | | | | | | |
| 4 | 7 | | 8 | | 9 | | 10 | | 11 | | 12 | | |
| 5 | | | | | | | | | | | | | |
| 6 | 18 | | 17 | | 16 | | 15 | | 14 | | 13 | | |
| 7 | | | | | | | | | | | | | |
| 8 | 19 | | 20 | | 21 | | 22 | | 23 | | 24 | | |
| 9 | | | | | | | | | | | | | |
| 10 | 30 | | 29 | | 28 | | 27 | | 26 | | 25 | | |
| 11 | | | | | | | | | | | | | |
| 12 | 31 | | 32 | | 33 | | 34 | | 35 | | 36 | | |
| 13 | | | | | | | | | | | | | |

A. Description of original monument and accessories and/or subsequent restoration:

A-7, T4N, R3W

1. Corner set in Original Government Survey by Musgrove Evans, Deputy Surveyor, in February & March 1827, "Set post cor. Secs. 18 & 19, Maple 10 N71°E, 25, Elm 9 S72°E, 51. G.L.O. distance from A-7 to M-7 is 24.42' South.

2. Pointed stone, tile etc. noted on May 22, 1930 by H.A. Williams in a marginal note of the Eaton County Road Commission copy of the Original Government Survey notes. Witnesses shown as: Elm 36 N53 1/2°E 32', Oneida's post S1°W 24'.

3. No further recorded information.

B. Description of corner evidence found and/or method applied in restoring or reestablishing corner:

A-7,

Found 1/2" bar 24.40' North of M-7, T4N, R4W, ±14.7' North of St. Joseph Highway & on woven wire fence line to the North. Dug 4' wide x 4.5' deep hole below bar & found 1.5' long pointed stone with clay tile around it. Measured 25.42' to M-7, T4N, R4W. Accepted stone as perpetuated location of A-7 & raised to surface with standard Remonumentation 3/4" form pin & cap.

C. Description of monument for corner and accessories established to perpetuate locating the position of the corner:

A-7, T4N-R3W

Set standard Remonumentation 3/4" form pin & cap "P.A. 345 L.S. 25832" as noted above

Found nail & tag #13039 in South side power pole, N50°E, 21.85'


Found nail & tag in East side anchor post, S35°W, 68.09'

Found 5/8" bar in monument box, M-7, T4N, R4W, South, 25.42'

North edge of asphalt, South, 2.1'

Found 1" pipe, Country Club Estates, N85°W, 165.52'

Set nail & tag #25832 in Northeast side power pole, S45°E, 97.06'

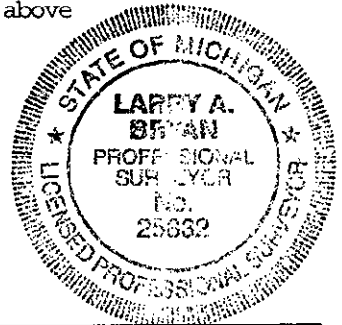

Signed by Larry A. Bryan
Surveyor's Michigan License No. 25832

Date 11-26-97

P.A. 345 EATON COUNTY
PEER APPROVED 10/14/97 ML