

**SURVEY &
REMONUMENTATION**

SEP 29 1994

**LAND CORNER RECORDATION CERTIFICATE
Filing Requirement of Act 74, Mich. P.A. 1970**

FILED
copy

94 JUN 15 AM 10: 28

For corners in

COMMISSION

<u>EATON</u> <small>(County)</small>	Located In:	Corner Code #
<u>Oneida Township</u>	T <u>4N</u> R <u>4W</u>	<u>H-8</u>
1. Public Land Survey	T _____ R _____	_____
	T _____ R _____	_____
	T _____ R _____	_____
2. Property Controlling in Section	S _____ T _____ R _____	_____
	S _____ T _____ R _____	_____
3. Miscellaneous Property in Sec.	S _____ T _____ R _____	_____
	S _____ T _____ R _____	_____
4. Lot No. _____, Recorded Plat _____		
5. Private Claims _____		

LINDA M. TWITCHELL
REGISTER OF DEEDS
EATON COUNTY, MICH.

L3 - P421

Register of Deeds Stamp & File Number

	A	B	C	D	E	F	G	H	I	J	K	L	M
2	6		5		4		3		2		1		
3													
4	7		8		9		10		11		12		
5													
6	16		17		18		15		14		13		
7													
8	19		20		21		22		23		24		
9													
10	30		29		28		27		26		25		
11													
12	31		32		33		34		35		36		
13													

R. W. Steadman, in a field survey on May 23, 1994, do hereby certify that under requirements of P.A. 74, Michigan P.A. of 1970, the corner points mentioned in lines 1 and 2 above were in conformance with regulations and rules therefore as required in the current manual of survey instructions of the United States Department of the Interior, Bureau of Land Management or by a decree of a Court of Law and/or that the corner points mentioned in lines 3, 4 and 5 above were in conformance with the rules of the Michigan Board of Land Surveyors or by a Decree of a Court of Law; established, re-established, monumented, re-monumented, recovered, found as expressed below:

NOTE: Not more than 4 corners, all in the same town and range, may be recorded on this certificate.

A. Description of original monument and accessories and/or subsequent restoration:

1). Since it was not included in the procedure for the United States Survey of the Public Lands, the establishment of the Section Center was customarily performed by the County Surveyor. In Record of Surveys, Vol. 1, Page 156, in an April 11, 1872 survey, County Surveyor W. H. Simpson states "Stake set according to law, S. Elm 10 N60E 6, W. Ash 10 S85-3/4W 23".

2). I find not further mention of this corner in public records or other sources.


3. Description of corner evidence found and/or method applied in restoring or reestablishing corner:

In the location indicated on the aerial photograph, found a rotted-off wood anchor post at the intersection of down fences running East, South, and West. Ownership is across the 1/4 line running North. Accepted the post as the best evidence of the corner location.

4. Description of monument for corner and accessories established to perpetuate locating the position of the corner:

Set standard Eaton County Remonumentation 3/4" smooth iron rod and cap stamped "P. A. 345, PS 11370" in center of anchor post hole to mark the corner and took the following witnesses (bearings are magnetic):

- Set nail and tag 11370 in S. side 12" Walnut N80°E 8.04'
- Set nail and tag 11370 in W. side 6" Wild Cherry N07°W 5.64'
- Set nail and tag 11370 in S. side 32" Maple S82°W 20.42'
- Set nail and tag 11370 in E. side 15" Maple S20°W 32.67'
- Set nail and tag 11370 in SW side 10" Maple S26°E 39.66'

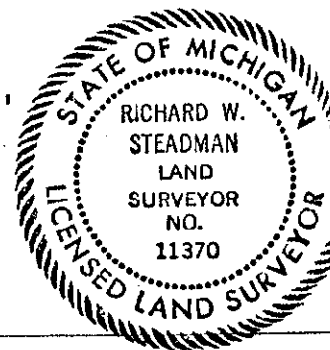

Signed by Richard W. Steadman

Date May 24, 1994

Surveyor's Michigan License No. 11370

P.A. 345 EATON COUNTY

PEER APPROVED 5/25/94