

DEC 17 1998

Copy
98 DEC -8 AM 8: 25

LAND CORNER RECORDATION CERTIFICATE
Filing Requirement of Act 74, Mich. P.A. 1970

SECTION

For corners in
ONEIDA TWP.
EATON
(County)

Located In: Corner Code #

- 1. Public Land Survey T 4N R 4W L-8
T _____ R _____
T _____ R _____
T _____ R _____
- 2. Property Controlling S _____ T _____ R _____
in Section S _____ T _____ R _____
- 3. Miscellaneous S _____ T _____ R _____
Property in Sec. S _____ T _____ R _____

LINDA M. TWITCHELL
REGISTER OF DEEDS
EATON COUNTY, MICH.

LIBER 3 PAGE 993

Register of Deeds Stamp & File Number

- 4. Lot No. _____, Recorded Plat _____
- 5. Private Claims _____

I, Anthony Bumstead, in a field survey on October 10, 1998 do hereby state that under requirements of P.A. 74, Michigan P.A. of 1970, the corner points mentioned in lines 1 and 2 above were in conformance with regulations and rules therefore as required in the current manual of survey instructions of the United States Department of the Interior, Bureau of Land Management or by a decree of a Court of Law and /or that the corner points mentioned in lines 3, 4 and 5 above were in conformance with the rules of the Michigan Board of Land Surveyors or by a Decree of a Court of Law; established, re-established, monumented, recovered, found as expressed below:

	A	B	C	D	E	F	G	H	I	J	K	L	M
1													
2	6			5			4		3			2	1
3													
4	7			8			9		10			11	12
5													
6	18			17			16		15			14	13
7													
8	19			20			21		22			23	●
9													
10	30			29			28		27			26	25
11													
12	31			32			33		34			35	36
13													

NOTE: Not more than 2 corners, all in the same town and range, may be recorded on this certificate.

A. Description of original monument and accessories and/or subsequent restoration:


- 1. Corner not set in Original Government Survey
- 2. County Survey Records by M.H. Bailey dated June 10, 1879 (Vol. 2, Page 100) calls for "Center of Section stake 3 stones Lon stone on top of mound"
- 3. No other recorded information

B. Description of corner evidence found and/or method applied in restoring or re-establishing corner:

At the intersection of an old four-way woven wire fence found remains of rotted fence post and a "bundle" of wire on top of a ring of stones. There were many stones of average size, none appearing to be "Long stone on top of mound". Traverse around the section yielded an intersection of the 1/4 lines 5.47 feet West and 0.66 feet South of the ring of stones. Accepted ring of stones as perpetuated location of L-8 as called for in Item A-2 above and set standard remonumentation form pin and cap "PA345 P.S. #41095 Eaton County" in depression left by corner post in center of stones. Measured South to L-9 a distance of 2649.97', North to L-7 a distance of 2645.11', West to K-8 a distance of 2642.63', and East to M-8 a distance of 2641.14'.

C. Description of monument for corner and accessories established to perpetuate locating the position of the corner:

- Set Remonumentation bar & cap as noted above.
- Set nail & tag #41095 West side 12" Ash, N05°W, 19.00'
- Set nail & tag #41095 South side 7" Triple Ash, S85°E, 24.05'
- Set nail & tag #41095 South side 11" Ash, S71°W, 26.94'
- Set nail & tag #41095 West side 13" Twin Locust, S17°E, 10.6'

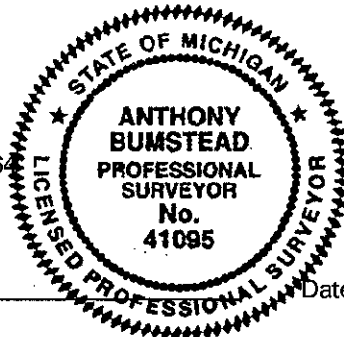

Signed by [Signature] Date 11-25-98
Surveyor's Michigan License No. 41095

P.A. 345 EATON COUNTY
PEER APPROVED 10/16/98 ML