

EATON COUNTY REMONUMENTATION  
 LAND CORNER RECORDATION CERTIFICATE  
 Filing Requirement of Act 74, Mich. P.A. 1970

FILED

For corners in

EATON

(County)

VERMONTVILLE TOWNSHIP

Located In:

Corner Code: #

93 SEP 15 PM 12: 21

- |                                    |   |           |   |           |               |
|------------------------------------|---|-----------|---|-----------|---------------|
| 1. Public Land Survey              | T | <u>3N</u> | R | <u>6W</u> | A-1           |
|                                    | T |           | R |           |               |
|                                    | T | <u>4N</u> | R | <u>6W</u> | <u>A-13</u> ✓ |
|                                    | T |           | R |           |               |
| 2. Property Controlling in Section | S |           | T | R         |               |
|                                    | S |           | T | R         |               |
| 3. Miscellaneous Property in Sec.  | S |           | T | R         |               |
|                                    | S |           | T | R         |               |

LINDA M. TWITCHELL  
 REGISTER OF DEEDS  
 EATON COUNTY, MICH.

LIBER 3 PAGE 232  
 Register of Deeds Stamp & File Number

4. Lot No. \_\_\_\_\_, Recorded Plat \_\_\_\_\_  
 5. Private Claims \_\_\_\_\_

|    | A  | B  | C  | D  | E  | F  | G | H | I | J | K | L | M |
|----|----|----|----|----|----|----|---|---|---|---|---|---|---|
| 2  | 6  | 5  | 4  | 3  | 2  | 1  |   |   |   |   |   |   |   |
| 3  |    |    |    |    |    |    |   |   |   |   |   |   |   |
| 4  | 7  | 8  | 9  | 10 | 11 | 12 |   |   |   |   |   |   |   |
| 5  |    |    |    |    |    |    |   |   |   |   |   |   |   |
| 6  | 18 | 17 | 16 | 15 | 14 | 13 |   |   |   |   |   |   |   |
| 7  |    |    |    |    |    |    |   |   |   |   |   |   |   |
| 8  | 19 | 20 | 21 | 22 | 23 | 24 |   |   |   |   |   |   |   |
| 9  |    |    |    |    |    |    |   |   |   |   |   |   |   |
| 10 | 30 | 29 | 28 | 27 | 26 | 25 |   |   |   |   |   |   |   |
| 11 |    |    |    |    |    |    |   |   |   |   |   |   |   |
| 12 | 31 | 32 | 33 | 34 | 35 | 36 |   |   |   |   |   |   |   |
| 13 |    |    |    |    |    |    |   |   |   |   |   |   |   |

I, BRIAN REYNOLDS, in a field survey on July 1, 19 93, do hereby certify that under requirements of P.A. 74, Michigan P.A. of 1970, the corner points mentioned in lines 1 and 2 above were in conformance with regulations and rules therefore as required in the current manual of survey instructions of the United States Department of the Interior, Bureau of Land Management or by a decree of a Court of Law and/or that the corner points mentioned in lines 3, 4 and 5 above were in conformance with the rules of the Michigan Board of Land Surveyors or by a Decree of a Court of Law; established, re-established, monumented, re-monumented, recovered, found as expressed below:

NOTE: Not more than 4 corners, all in the same town and range, may be recorded on this certificate.

A. Description of original monument and accessories and/or subsequent restoration:  
 See compiled historical information on reverse.

B. Description of corner evidence found and/or method applied in restoring or reestablishing corner:

Found Nederveld witnesses and square head bolt (bent) excavated further and found stone approx 8"x8"x24" listing heavily to West. Also found iron (1/2"x10" spike) near bottom of stone. Top of square head bolt approximately center of bottom of stone. Checked distances West and North, found distances West to be 4'± longer than record, distance North to 1/4 line occupation 4'± shorter than record. 1/16 line occupation. West checks within 2'± both North and South. Accepted base of stone as best available evidence of corner position.

C. Description of monument for corner and accessories established to perpetuate locating the position of the corner:

Set standard 3/4"x24" Barry County Remonumentation iron bar and aluminum disk inscribed "PS 31602."

Witnesses to monument:


Set 40d nail and tag in W side of 6" Elm N20°E 110.68 feet

Set 40d nail and tag in W side of 6" Elm N36°E 59.78 feet

Δ Conc. post S52°W 41.20 feet

Set 40d nail and tag in S side of 24" Oak N82°W 397.20 feet

Note: Witness tags are round orange plastic discs inscribed "REYNOLDS 31602."

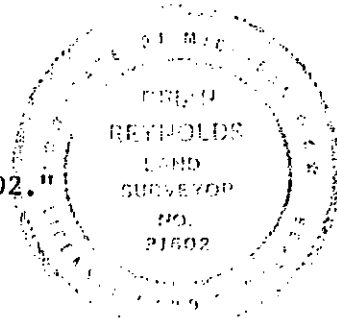

Signed by [Signature]

Date July 7, 1993

Surveyor's Michigan License No. 31602

Township corner established by General Land Office Deputy Surveyor Lucius Lyon 42.89 chains North of A-2, 47.63 chains West of B-13, T4N, R6W. Beech 28 S17°W 33 D<sub>2</sub> 26 N27°W 23. A survey by Eaton County Surveyor Oscar G. Church, March 26, 1878, of Section 31, T4N, R6W, notes in book 2, Page 63, "This corner was established by the Barry & Eaton County Surveyors working together." Stone (no witnesses). Notes by Frank S. Bowen, Barry County Surveyor, March 30, 1878, 40.31 chains to L-1, T3N, R7W, 42.91 chains to M-2, T3N, R7W, no witnesses or monument recited. Notes by Frank S. Bowen (L. 1, P. 228, Barry County Surveyor's Record) Survey of Section 36, T4N, R7W, "To establish East line. Joint survey with Oscar Church, Surveyor of Eaton County." "Set stone and iron bar for corner to the four townships by roots of old bearing trees." 40.00 chains to M-12, T4N, R7W, 39.91 chains from L-13, T4N, R7W. No witnesses.

Survey by Nederveld (no date) (Gordon Nederveld, Professional Surveyor #21272) found 1" square iron 2" N of C/L E-W bit road & in C/L N-S gravel road.

E. point of conc. hyd post S45°W 40.75'

"V" mark on top E. end 115" CMP S25°E 44.15'

E. edge flange to stop sign post N20°W, 36.75'

N. edge flange to stop sign post S80°E 53.68'

Barry County Road Commission  
corner book

Stone 14" Walnut S40W 46.4

24" Walnut S50E 65.4

Corner post N45E 39.9

20" Elm N45W 26.1 no name or date

Eaton County Road Commission (construction plans for Kelly Highway, 1966)

P.O.E. Stall 10+68.42

1" Iron on original stone

Cor. post WSW 45.40'

Cor. post SSW 42.90'

FAS marker SW 40.75'

Road name post NW 41.95'