

SURVEY & REMONUMENTATION

SEP 29 1994

COMMISSION

**EATON COUNTY REMONUMENTATION
LAND CORNER RECORDATION CERTIFICATE
Filing Requirement of Act 74, Mich. P.A. 1970**

FILED

Copy

94 AUG 18 PM 4:18

LINDA M. TWITCHELL
REGISTER OF DEEDS
EATON COUNTY, MICH.

L.B. Pg 445

Register of Deeds Stamp & File Number

corners in

EATON

(County)

Located In:

Corner Code =#

Public Land Survey

T 4N R 6W C-9
T _____ R _____ SUNFIELD TWSP.
T _____ R _____ COR. SEC. 19,20,29 & 30
T _____ R _____

Property Controlling in Section

S _____ T _____ R _____
S _____ T _____ R _____

Miscellaneous

S _____ T _____ R _____

Property in Sec.

S _____ T _____ R _____

Lot No. _____, Recorded Plat _____

Private Claims _____

| | A | B | C | D | E | F | G | H | I | J | K | L | M |
|----|----|----|----|----|----|----|---|---|---|---|---|---|---|
| 2 | 6 | 5 | 4 | 3 | 2 | 1 | | | | | | | |
| 3 | | | | | | | | | | | | | |
| 4 | 7 | 8 | 9 | 10 | 11 | 12 | | | | | | | |
| 5 | | | | | | | | | | | | | |
| 6 | 18 | 17 | 16 | 15 | 14 | 13 | | | | | | | |
| 7 | | | | | | | | | | | | | |
| 8 | 19 | 20 | 21 | 22 | 23 | 24 | | | | | | | |
| 9 | | ● | | | | | | | | | | | |
| 10 | 30 | 29 | 28 | 27 | 26 | 25 | | | | | | | |
| 11 | | | | | | | | | | | | | |
| 12 | 31 | 32 | 33 | 34 | 35 | 36 | | | | | | | |
| 13 | | | | | | | | | | | | | |

BRIAN REYNOLDS, in a field survey on 14 JULY, 1994, hereby certify that under requirements of P.A. 74, Michigan P.A. of 1970, the corner points mentioned in lines 1 and 2 above were in conformance with regulations and rules therefore as required in the present manual of survey instructions of the United States Department of the Interior, Bureau of Land Management or by a decree of a Court of Law and/or that the corner points mentioned in lines 3, 4 and 5 above were in conformance with the rules of the Michigan Board of Land Surveyors or by a Decree of a Court of Law; established, re-established, monumented, re-monumented, recovered, found as pressed below:


NOTE: Not more than 4 corners, all in the same town and range, may be recorded on this certificate.

Description of original monument and accessories and/or subsequent restoration:

- GENERAL LAND OFFICE: ORANGE RISDON D.S., COPIED BY MORELL E. NEWCOMB, 01APR1908, BEECH - 18 - N59E - 1; Do. - 12 - S57W - 41
- COUNTY SURVEYOR OSCAR C. CHURCH: STONE, 4APR 1878
- FRED WHITE, PS# 12034, IN THE CONTEXT OF A MORTGAGE INSPECTION, 7-16-1985, FOUND BUT DID NOT VERIFY IRON ON CENTERLINE OF IRISH ROAD, 5'+/- SOUTH OF CENTERLINE OF MT. HOPE HWY. 40" MAPLE - NW - 16.15'; 24" SHAGBARK HICKORY - S60W - 16.15'; P.P. - S59W - 48.61'

Description of corner evidence found and/or method applied in restoring or reestablishing corner:

- PRELIMINARY FIELD CHECK: EXCAVATED OVER MAGNETIC PULL TO FIND 1/2" UNCAPPED IRON (+/- 5' SOUTH OF CENTERLINE, ON CENTERLINE EAST/WEST). FOUND WITNESS TAG IN UTILITY POLE (P.S. # MATCHING THAT OF FRED WHITE).
- AFTER SECTION TRAVERSE INCLUDING TIES TO OCCUPATION LINES, ACCEPTED FOUND IRON AS BEST AVAILABLE EVIDENCE OF CORNER POSITION. REPLACED FOUND IRON WITH STANDARD REMON. IRON (3/4" x 24" WITH ORANGE PLASTIC CAP " PA 345 #31602 ")
- C-9 EAST TO 1/8 LINE OCCUPATION: 1319.0'; 1/8 LINE OCCUPATION EAST TO D-9:1316.0'; C-9 EAST TO D-9: 2635.00'; C-9 SOUTH TO C-10: 2638.97'

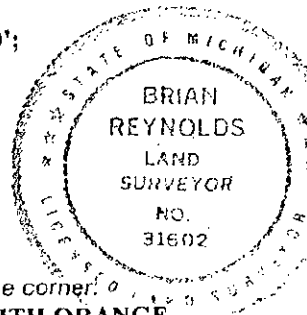

Description of monument for corner and accessories established to perpetuate locating the position of the corner:

- FOUND 1/2" IRON: REPLACED WITH STANDARD EATON Co. REMON. IRON (3/4 x 24" WITH ORANGE PLASTIC CAP "PA 345 #31602") AND INSTALLED MON. BOX. CORNER IS ON CENTERLINE NORTH & SOUTH; +/- 5' SOUTH OF CENTERLINE EAST/WEST. FOUND NAIL & YELLOW TAG (#12034) - NW. FACE - UTILITY POLE - S77W - 48.56'
- SET 5" SPIKE & ORANGE PLASTIC "REYNOLDS #31602" TAG - NW. FACE - 20" HICKORY - S79W - 71.53'
- SET 5" SPIKE & ORANGE PLASTIC "REYNOLDS #31602" TAG - NW. FACE - 24" MULBERRY - S73W - 169.00'
- SET 1/2" IRON WITH ORANGE PLASTIC "REYNOLDS TRAV PT" CAP - ON EDGE OF BITUMINOUS - S74E - 45.55'
- SET 1/2" IRON WITH ORANGE PLASTIC "REYNOLDS TRAV PT" CAP - ON EDGE OF BITUMINOUS - N78E - 56.24'

Witnessed by [Signature]

Date JULY 27, 1994

Surveyor's Michigan License No. 31602