

**SURVEY &  
REMONUMENTATION**

SEP 29 1994

**EATON COUNTY REMONUMENTATION  
LAND CORNER RECORDATION CERTIFICATE  
Filing Requirement of Act 74, Mich. P.A. 1970**

FILED

*copy*

94 AUG 18 PM 4: 18

or corners in **COMMISSION  
EATON**

LINDA M. TWITCHELL  
REGISTER OF DEEDS  
EATON COUNTY, MICH.

L.3 Pg 446

Register of Deeds Stamp & File Number

Located In: \_\_\_\_\_ Corner Code ~~##~~

Public Land Survey T 4N R 6W C-10  
T \_\_\_\_\_ R \_\_\_\_\_ SUNFIELD TWSP.  
T \_\_\_\_\_ R \_\_\_\_\_ 1/4 COR. SEC. 29 & 30  
T \_\_\_\_\_ R \_\_\_\_\_  
Property Controlling S \_\_\_\_\_ T \_\_\_\_\_ R \_\_\_\_\_  
in Section S \_\_\_\_\_ T \_\_\_\_\_ R \_\_\_\_\_  
Miscellaneous S \_\_\_\_\_ T \_\_\_\_\_ R \_\_\_\_\_  
Property in Sec. S \_\_\_\_\_ T \_\_\_\_\_ R \_\_\_\_\_

Lot No. \_\_\_\_\_, Recorded Plat \_\_\_\_\_  
Private Claims \_\_\_\_\_

	A	B	C	D	E	F	G	H	I	J	K	L	M
2	6		5		4		3		2		1		
3													
4	7		8		9		10		11		12		
5													
6	18		17		16		15		14		13		
7													
8	19		20		21		22		23		24		
9													
10	30		29		28		27		26		25		
11													
12	31		32		33		34		35		36		
13													


**BRIAN REYNOLDS**, in a field survey on 14 JULY, 19 94,

do hereby certify that under requirements of P.A. 74, Michigan P.A. of 1970, the corner points mentioned in lines 1 and 2 above were in conformance with regulations and rules therefore as required in the current manual of survey instructions of the United States Department of the Interior, Bureau of Land Management or by a decree of a Court of Law and/or that the corner points mentioned in lines 3, 4 and 5 above were in conformance with the rules of the Michigan Board of Land Surveyors or by a Decree of a Court of Law; established, re-established, monumented, re-monumented, recovered, found as expressed below:

**NOTE:** Not more than 4 corners, all in the same town and range, may be recorded on this certificate.

Description of original monument and accessories and/or subsequent restoration:

- GENERAL LAND OFFICE: ORANGE RISDON D.S.,  
COPIED BY MORELL E. NEWCOMB, 01 APR 1908, BEECH - 9 - S87E - 34; SUGAR - 12 - N79W - 57
- COUNTY SURVEYOR OSCAR C. CHURCH: 40.04ch. N. TO C-9; 39.95 1/2ch. S. TO C-11; STAKE PREVIOUSLY SET, 5 MAY 1874

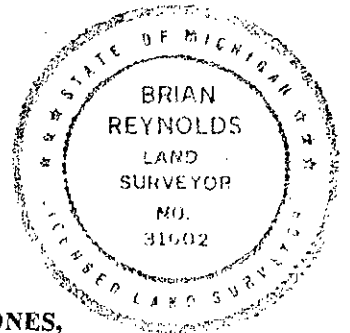

Description of corner evidence found and/or method applied in restoring or reestablishing corner:

- PRELIMINARY FIELD CHECK: NOTHING FOUND, OCCUPATION EAST & WEST.
- SECONDARY CHECK: EXCAVATED WITH BACK-HOE TO FIND A CIRCLE OF 10 STONES, (4" x 4" ) AT NATURAL GRADE FITTING OCCUPATION EAST & WEST AND CENTERLINE NORTH & SOUTH. ALSO TRACES OF DECAYED WOOD IN CIRCLE OF STONES.
- ACCEPTED DECAYED WOOD IN CIRCLE OF STONES AS THE PERPETUATION OF CORNER BY CHURCH. SET STANDARD REMON. IRON (3/4" x 24" WITH ORANGE PLASTIC CAP "PA 345 #31602")

Description of monument for corner and accessories established to perpetuate locating the position of the corner:

- FOUND CIRCLE OF STONES AND DECAYED WOOD: REPLACED WITH STANDARD EATON Co. REMON. IRON (3/4" x 24" WITH ORANGE PLASTIC CAP "PA 345 #31602").  
ON CENTERLINE NORTH & SOUTH, ON OCCUPATION FENCE/TREE ROW EAST & WEST.
- SET 5" SPIKE WITH ORANGE PLASTIC "REYNOLDS #31602" TAG - N. FACE - 16" ASH - S79E - 29.30'
- SET 5" SPIKE WITH ORANGE PLASTIC "REYNOLDS #31602" TAG - NW. FACE - 16" OAK - N32E - 35.19'
- SET 5" SPIKE WITH ORANGE PLASTIC "REYNOLDS #31602" TAG - NW. FACE - 16" OAK - N20E - 76.75'
- SET 5" SPIKE WITH ORANGE PLASTIC "REYNOLDS #31602" TAG - SW. FACE - SOUTHERNMOST TRUNK - 8" ASH TRIPLE - N34W - 39.27'
- SET 5" SPIKE WITH ORANGE PLASTIC "REYNOLDS #31602" TAG - N. FACE - 10" ELM - S73W - 32.25'

signed by [Signature] Date JULY 27, 1994

Surveyor's Michigan License No. 31602