

**SURVEY & REMONUMENTATION**

FILED

COPY

SEP 29 1994

**EATON COUNTY REMONUMENTATION**

**LAND CORNER RECORDATION CERTIFICATE**

94 SEP 28 AM 11:08

Filing Requirement of Act 74, Mich. P.A. 1970

**COMMISSION**

For corners in

**EATON**

(County)

Located In:

Corner Code #/

1. Public Land Survey	T	<u>4N</u>	R	<u>6W</u>	<u>C-11</u>
<b>SUNFIELD TWSP.</b>	T	_____	R	_____	_____
<b>COR. SEC. 29,30,31 &amp; 32</b>	T	_____	R	_____	_____
	T	_____	R	_____	_____
2. Property Controlling in Section	S	_____	T	_____	_____
	S	_____	T	_____	_____
3. Miscellaneous Property in Sec.	S	_____	T	_____	_____
	S	_____	T	_____	_____

LINDA M. TWITCHELL  
REGISTER OF DEEDS  
EATON COUNTY, MICH.

L.3 Pg 454

Register of Deeds Stamp & File Number

4. Lot No. \_\_\_\_\_, Recorded Plat \_\_\_\_\_  
5. Private Claims \_\_\_\_\_


	A	B	C	D	E	F	G	H	I	J	K	L
2	6		5		4		3		2		1	
3												
4	7		8		9		10		11		12	
5												
6	18		17		16		15		14		13	
7												
8	19		20		21		22		23		24	
9												
10	30		29		28		27		26		25	
11												
12	31		32		33		34		35		36	
13												

I, **BRIAN REYNOLDS**, in a field survey on 14 JULY, 1994, do hereby certify that under requirements of P.A. 74, Michigan P.A. of 1970, the corner points mentioned in lines 1 and 2 above were in conformance with regulations and rules therefore as required in the current manual of survey instructions of the United States Department of the Interior, Bureau of Land Management or by a decree of a Court of Law and/or that the corner points mentioned in lines 3, 4 and 5 above were in conformance with the rules of the Michigan Board of Land Surveyors or by a Decree of a Court of Law; established, re-established, monumented, re-monumented, recovered, found as expressed below:

**NOTE: Not more than 4 corners, all in the same town and range, may be recorded on this certificate.**

A. Description of original monument and accessories and/or subsequent restoration:

1. GENERAL LAND OFFICE: ORANGE RISDON D.S., COPIED BY MORELL E. NEWCOMB, 01APR1908, BEECH - 8 - N70W - 8; Do. - 6 - S70E - 64
2. COUNTY SURVEYOR OSCAR C. CHURCH: STAKE; 5 MAY 1874
3. COUNTY SURVEYOR OSCAR C. CHURCH: STONE; 26 MAR 1878

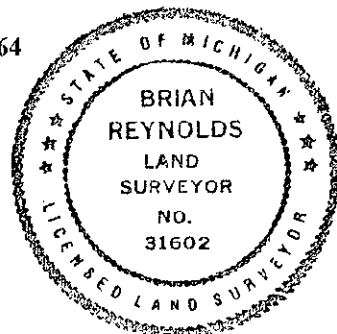

B. Description of corner evidence found and/or method applied in restoring or reestablishing corner:

**PRELIMINARY FIELD CHECK: NOTHING FOUND; BITUMINOUS ROAD EAST AND WEST, GRAVEL ROAD NORTH AND SOUTH**  
**SECONDARY CHECK: AFTER TRAVERSE OF SECTIONS 29 AND 32 WITH TIES TO OCCUPATION, AND ADDITIONAL TIES TO OCCUPATION ALONG ROAD BETWEEN SECTIONS 30 AND 31, EXCAVATED THROUGH BLACKTOP AT LOCATION CONSISTENT WITH 1/4 LINE AND 1/8 LINE OCCUPATION WEST, NORTH AND EAST, AND COUNTY SURVEYOR DISTANCES. FOUND NOTHING.**  
**ACCEPTED BEST FIT OF OCCUPATION EVIDENCE AND COUNTY SURVEYOR RECORD DISTANCES AS BEST EVIDENCE OF CORNER POSITION.**

C. Description of monument for corner and accessories established to perpetuate locating the position of the corner:

- SET STANDARD EATON COUNTY REMON. IRON 3/4" x 24" FORM PIN WITH ORANGE PLASTIC " PA 345 #31603 " CAP, AND MONUMENT BOX:
- ON CENTERLINE EAST/WEST ROAD AND APPROXIMATE CENTERLINE NORTH/SOUTH ROAD
- SET 5" SPIKE WITH ORANGE REYNOLDS PLASTIC WITNESS TAG - SE. SIDE - UTILITY POLE (#VE1-184) - NAZ 309 - 104.89'
- SET 1/2" IRON WITH ORANGE PLASTIC "REYNOLDS TRAV PT " CAP - ON NORTH EDGE OF BITUMINOUS SURFACE ROAD - NAZ 71 - 41.11'
- SET 5" SPIKE WITH ORANGE REYNOLDS PLASTIC WITNESS TAG - NE. FACE - 10" ELM - NAZ 126 - 60.32'
- SET 5" SPIKE WITH ORANGE REYNOLDS PLASTIC WITNESS TAG - NW. FACE - 12" ELM - NAZ 200 - 107.39'

Signed by

Date SEPT 28, 1994

Surveyor's Michigan License No. 31602

P.A. 345 EATON COUNTY APPROVED BY MICHIGAN STATE BOARD OF LAND SURVEYORS, JAN. 28, REVISED MAY 14, REVISOR JAN. PEER APPROVED 8/24/94 MR