

**SURVEY & REMONUMENTATION**

SEP 29 1994

EATON COUNTY REMONUMENTATION

COMMISSION

LAND CORNER RECORDATION CERTIFICATE

Filing Requirement of Act 74, Mich. P.A. 1970

FILED

*copy*

94 AUG 18 PM 4: 17

LINDA M. TWITCHELL  
REGISTER OF DEEDS  
EATON COUNTY, MICH.

L.3 Pg 444

Register of Deeds Stamp & File Number

or corners in

EATON

(County)

Located In:

Corner Code #

Public Land Survey

T 4N R 6W C-12  
T \_\_\_\_\_ R SUNFIELD TWSP.  
T \_\_\_\_\_ R 1/4 COR. SEC. 31 & 32  
T \_\_\_\_\_ R \_\_\_\_\_  
T \_\_\_\_\_ R \_\_\_\_\_

Property Controlling  
in Section  
Miscellaneous  
Property in Sec.

S \_\_\_\_\_ T \_\_\_\_\_ R \_\_\_\_\_  
S \_\_\_\_\_ T \_\_\_\_\_ R \_\_\_\_\_  
S \_\_\_\_\_ T \_\_\_\_\_ R \_\_\_\_\_  
S \_\_\_\_\_ T \_\_\_\_\_ R \_\_\_\_\_

Lot No. \_\_\_\_\_, Recorded Plat \_\_\_\_\_  
Private Claims \_\_\_\_\_

	A	B	C	D	E	F	G	H	I	J	K	L	M
2	6		5		4		3		2		1		
3													
4	7		8		9		10		11		12		
5													
6	18		17		16		15		14		13		
7													
8	19		20		21		22		23		24		
9													
10	30		29		28		27		26		25		
11													
12	31		32		33		34		35		36		
13													


**BRIAN REYNOLDS**, in a field survey on 14 JULY, 19 94

do hereby certify that under requirements of P.A. 74, Michigan P.A. of 1970, the corner points mentioned in lines 1 and 2 above were in conformance with regulations and rules therefore as required in the current manual of survey instructions of the United States Department of the Interior, Bureau of Land Management or by a decree of a Court of Law and/or that the corner points mentioned in lines 3, 4 and 5 above were in conformance with the rules of the Michigan Board of Land Surveyors or by a Decree of a Court of Law; established, re-established, monumented, re-monumented, recovered, found as expressed below:

**NOTE: Not more than 4 corners, all in the same town and range, may be recorded on this certificate.**

Description of original monument and accessories and/or subsequent restoration:

- GENERAL LAND OFFICE: ORANGE RISDON D.S., COPIED BY MORELL E. NEWCOMB, 01APR1908, BEECH - 20
- N33E - 14; SUGAR - 12 - S37W - 47
- COUNTY SURVEYOR OSCAR C. CHURCH; ; FOUND STONE, 26 MAR 1878

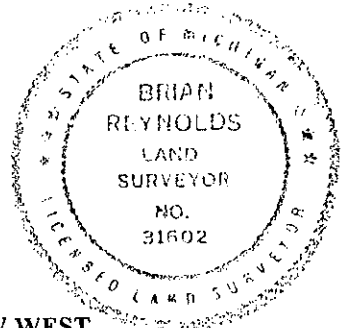

Description of corner evidence found and/or method applied in restoring or reestablishing corner:

- PRELIMINARY FIELD CHECK: NOTHING FOUND, OCCUPATION FENCE/TREE ROW WEST.
- SECONDARY CHECK: EXCAVATED WITH BACK-HOE TO FIND POINTED STONE (8" x 8" x 14") AND TRACES OF DECAYED WOOD AT NATURAL GRADE, FITTING OCCUPATION WEST AND CENTERLINE NORTH & SOUTH.
- ACCEPTED POINTED STONE AS THE PERPETUATION OF CORNER AS ESTABLISHED BY CHURCH, 1878. SET STANDARD REMON. IRON (3/4" x 24" WITH ORANGE PLASTIC CAP "PA 345 #31602").

Description of monument for corner and accessories established to perpetuate locating the position of the corner:

- FOUND (8" x 8" x 14") POINTED STONE: REPLACED WITH STANDARD EATON Co. REMON. IRON (3/4" x 24" WITH ORANGE PLASTIC CAP "PA 345 #31602); ON OCCUPATION FENCE/TREE ROW WEST; ON CENTERLINE NORTH & SOUTH.
- SET 5" SPIKE WITH ORANGE PLASTIC "REYNOLDS #31602" TAG - NORTHERLY TRUNK - 5" ELM CLUSTER - N60W - 35.88'
- SET 5" SPIKE WITH ORANGE PLASTIC "REYNOLDS #31602" TAG - S. FACE - 20" BEECH - N70E - 58.22'
- SET 5" SPIKE WITH ORANGE PLASTIC "REYNOLDS #31602" TAG - N. FACE - 16" BEECH - N88E - 74.55'
- SET 5" SPIKE WITH ORANGE PLASTIC "REYNOLDS #31602" TAG - N. FACE - 16" POPLAR - S45E - 34.20'

signed by

*[Signature]*

Date JULY 27, 1994

Surveyor's Michigan License No. 31602

P.A. 345 EATON COUNTY  
PEER APPROVED 7/27/94 M