

**SURVEY & REMONUMENTATION**

SEP 29 1994

**EATON COUNTY REMONUMENTATION**

**LAND CORNER RECORDATION CERTIFICATE**

Filing Requirement of Act 74, Mich. P.A. 1970

**COMMISSION**

corners in

**EATON**

(County)

Located In:

Corner Code #

Public Land Survey

T 4N R 6W D-9  
 T \_\_\_\_\_ R SUNFIELD TWSP.  
 T \_\_\_\_\_ R 1/4 COR. SEC. 20 & 29  
 T \_\_\_\_\_ R \_\_\_\_\_  
 S \_\_\_\_\_ T \_\_\_\_\_ R \_\_\_\_\_  
 S \_\_\_\_\_ T \_\_\_\_\_ R \_\_\_\_\_  
 S \_\_\_\_\_ T \_\_\_\_\_ R \_\_\_\_\_  
 S \_\_\_\_\_ T \_\_\_\_\_ R \_\_\_\_\_

Property Controlling

in Section

Miscellaneous

Property in Sec.

**FILED**

*Copy*

94 AUG 18 PM 4:17

LINDA M. TWITCHELL  
 REGISTER OF DEEDS  
 EATON COUNTY, MICH.

**L3 Pg 443**  
 Register of Deeds Stamp & File Number

Lot No. \_\_\_\_\_, Recorded Plat \_\_\_\_\_  
 Private Claims \_\_\_\_\_

	A	B	C	D	E	F	G	H	I	J	K	L	M
2	6		5		4		3		2		1		
3													
4	7		8		9		10		11		12		
5													
6	18		17		16		15		14		13		
7													
8	19		20		21		22		23		24		
9													
10	30		29		28		27		26		25		
11													
12	31		32		33		34		35		36		
13													

**BRIAN REYNOLDS**, in a field survey on 14 JULY, 19 94,

hereby certify that under requirements of P.A. 74, Michigan P.A. of 1970, the corner points mentioned in lines 1 and 2 above were in conformance with regulations and rules therefore as required in the present manual of survey instructions of the United States Department of the Interior, Bureau of Land Management or by a decree of a Court of Law and/or that the corner points mentioned in lines 3, 4 and 5 above were in conformance with the rules of the Michigan Board of Land Surveyors or by a Decree of a Court of Law; established, re-established, monumented, re-monumented, recovered, found as crossed below:


**NOTE:** Not more than 4 corners, all in the same town and range, may be recorded on this certificate.

Description of original monument and accessories and/or subsequent restoration:

- GENERAL LAND OFFICE: ORANGE RISDON D.S., COPIED BY MORELL E. NEWCOMB, 01APR1908, WEST CORRECTED DISTANCE: 39.78ch.;
- SUGAR - 28 - S70W - 15; BEECH - 40 - N49E - 35
- COUNTY SURVEYOR OSCAR C. CHURCH: 40.00ch. TO C-9; 39.96ch. TO E-9; STAKE; 5 MAY 1874

Description of corner evidence found and/or method applied in restoring or reestablishing corner:

- PRELIMINARY FIELD CHECK: NOTHING FOUND; OCCUPATION FENCE/TREE ROW SOUTH.
- SET CORNER ON LINE BETWEEN E-9 & C-9 AT A PROPORTIONAL DISTANCE TO CHURCH'S DISTANCES FROM SURVEY ON 5 MAY 1874. ( COMPUTED CORNER POSITION FIT OCCUPATION SOUTH )
- C-9 TO D-9 MEASURES 2635.00'; D-9 TO E-9 MEASURES 2632.36'

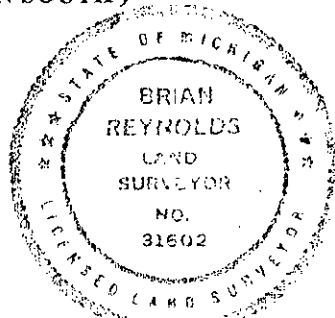

Description of monument for corner and accessories established to perpetuate locating the position of the corner:

- SET STANDARD EATON Co. REMON. IRON (3/4" x 24" WITH ORANGE PLASTIC CAP "PA 345 #31602"); +/- 1.5' SOUTH OF CENTERLINE EAST/WEST; ON OCCUPATION FENCE/TREE ROW SOUTH.
- SET 5" SPIKE WITH ORANGE "REYNOLDS #31602" TAG - N. FACE - N. TRUNK - 10" MULTIPLE TRUNK COTTONWOOD - S72E - 181.00'
- SET SET 5" SPIKE WITH ORANGE "REYNOLDS #31602" TAG - HIGH ON W. FACE - W. TRUNK - 12" MULTIPLE MAPLE - S9W - 80.45'
- SET SET 5" SPIKE WITH ORANGE "REYNOLDS #31602" TAG - N. FACE - 10" COTTONWOOD - S40E - 33.14'
- SET 1/2" IRON WITH ORANGE PLASTIC "REYNOLDS TRAV PT" CAP - +/-2' N. OF BITUMINOUS EDGE - N28W - 19.76'

Recorded by

*[Signature]*

Date

JULY 27, 1994

Surveyor's Michigan License No.

31602