

SURVEY & REMONUMENTATION

SEP 29 1994

COMMISSION

**EATON COUNTY REMONUMENTATION
LAND CORNER RECORDATION CERTIFICATE
Filing Requirement of Act 74, Mich. P.A. 1970**

FILED

copy

94 AUG 18 PM 4: 17

LINDA M. TWITCHELL
REGISTER OF DEEDS
EATON COUNTY, MICH.

L.3 Pg 442

Register of Deeds Stamp & File Number

corners in EATON
(County)

Located In: Corner Code #

Public Land Survey T 4N R 6W D-10
T _____ R _____ SUNFIELD TWSP.
T _____ R _____ CENTER SEC. 29
T _____ R _____
Property Controlling S _____ T _____ R _____
in Section S _____ T _____ R _____
Miscellaneous S _____ T _____ R _____
Property in Sec. S _____ T _____ R _____

Lot No. _____, Recorded Plat _____
Private Claims _____


	A	B	C	D	E	F	G	H	I	J	K	L	M
2	6		5		4		3		2		1		
3													
4	7		8		9		10		11		12		
5													
6	16		17		16		15		14		13		
7													
8	19		20		21		22		23		24		
9													
10	30		29		28		27		26		25		
11													
12	31		32		33		34		35		36		
13													

BRIAN REYNOLDS, in a field survey on 14 JULY, 19 94, hereby certify that under requirements of P.A. 74, Michigan P.A. of 1970, the corner points mentioned in lines 1 and 2 above were in conformance with regulations and rules theretofore as required in the current manual of survey instructions of the United States Department of the Interior, Bureau of Land Management or by a decree of a Court of Law and/or that the corner points mentioned in lines 3, 4 and 5 above were in conformance with the rules of the Michigan Board of Land Surveyors or by a Decree of a Court of Law; established, re-established, monumented, re-monumented, recovered, found as expressed below:

NOTE: Not more than 4 corners, all in the same town and range, may be recorded on this certificate.

Description of original monument and accessories and/or subsequent restoration:

- GENERAL LAND OFFICE: NOT SET BY G. L. O.
- COUNTY SURVEYOR OSCAR C. CHURCH: 40.00ch. N. TO D-9, 40.02ch. S. TO D-11, 39.86 1/2ch. W. TO C-10, 39.86 1/2ch. E. TO E-10; STAKE: W. OAK - 18 - N19W - 48 1/2, BASSWOOD - N74W - 31

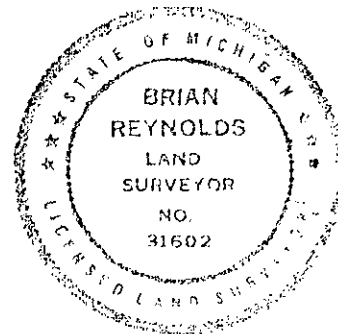

Description of corner evidence found and/or method applied in restoring or reestablishing corner:

- PRELIMINARY FIELD CHECK: FOUND LARGE STONE (16 x 14 x 20) AT 6" WOODEN FENCE CORNER; BURIED FENCE NORTH, +/- 5' EAST; TRACES OF FENCE SOUTH, +/- 9' EAST; ON STANDING FENCE EAST & WEST.; SECOND 6" WOODEN FENCE CORNER +/- 9' EAST (WITH NO DISTINGUISHABLE ACCESSORIES)
- SECONDARY CHECK: FOUND TRACES OF FENCE DIRECTLY NORTH AND SOUTH OF STONE AND FENCE CORNER. CLOSER OBSERVATION OF STONE YIELDED WHAT LOOKED TO BE A CHISLED HOLE IN THE CENTER OF A HIGH SPOT CENTRALLY LOCATED ON THE TOP FACE OF STONE.
- ACCEPTED STONE AS BEST EVIDENCE OF CORNER POSITION.

Description of monument for corner and accessories established to perpetuate locating the position of the corner:

- FOUND (16 x 14 x 20) STONE, REPLACED WITH STANDARD EATON Co. REMON. IRON (3/4" x 24" WITH ORANGE PLASTIC CAP "PA345 #31602":
(REMON. IRON SURROUNDED WITH 10" DIA. STONES)
STANDING FENCE EAST & WEST; TRACES OF FENCE NORTH & SOUTH
TRACES OF FENCE NORTH +/- 5' EAST
STANDING FENCE SOUTH AND FENCE CORNER +/- 9' EAST
SET 5" SPIKE & ORANGE PLASTIC "REYNOLDS #31602" TAG - S. FACE - 12" OAK - N85E - 19.01'
SET 5" SPIKE & ORANGE PLASTIC "REYNOLDS #31602" TAG - SW. FACE - W, TRUNK - DOUBLE ELM - N10W - 32.22'
SET 5" SPIKE & ORANGE PLASTIC "REYNOLDS #31602" TAG - S. FACE - 24" HICKORY - N70E - 34.64'
SET 5" SPIKE & ORANGE PLASTIC "REYNOLDS #31602" TAG - N. FACE - 5" ASH - N60E - 15.07'
SET 5" SPIKE & ORANGE PLASTIC "REYNOLDS #31602" TAG - E. FACE - E. TRUNK - 10" ASH TRIPLE - S5W - 17.54'

Witnessed by [Signature] Date July 30, 1994
Surveyor's Michigan License No. 31602