

SEP 29 1994

COMMISSION

EATON COUNTY REMONUMENTATION

LAND CORNER RECORDATION CERTIFICATE

Filing Requirement of Act 74, Mich. P.A. 1970

FILED

copy

94 AUG 18 PM 4:17

LINDA M. TWITCHELL
REGISTER OF DEEDS
EATON COUNTY, MICH.

L.3 Pg 441

Register of Deeds Stamp & File Number

For corners in EATON
(County)

Located In: Corner Code #/

- 1. Public Land Survey T 4N 6W D-12
T _____ R _____ SUNFIELD TWSP.
T _____ R _____ CENTER SEC. 32
T _____ R _____
- 2. Property Controlling S _____ T _____ R _____
in Section S _____ T _____ R _____
- 3. Miscellaneous S _____ T _____ R _____
Property in Sec. S _____ T _____ R _____

- 4. Lot No. _____, Recorded Plat _____
- 5. Private Claims _____


	A	B	C	D	E	F	G	H	I	J	K	L	M
2	6		5		4		3		2		1		
3													
4	7		8		9		10		11		12		
5													
6	13		17		16		15		14		13		
7													
8	19		20		21		22		23		24		
9													
10	30		29		28		27		26		25		
11													
12	31		32		33		34		35		36		
13													

I, BRIAN REYNOLDS, in a field survey on 14 JULY, 19 94, do hereby certify that under requirements of P.A. 74, Michigan P.A. of 1970, the corner points mentioned in lines 1 and 2 above were in conformance with regulations and rules therefore as required in the current manual of survey instructions of the United States Department of the Interior, Bureau of Land Management or by a decree of a Court of Law and/or that the corner points mentioned in lines 3, 4 and 5 above were in conformance with the rules of the Michigan Board of Land Surveyors or by a Decree of a Court of Law; established, re-established, monumented, re-monumented, recovered, found as expressed below:

NOTE: Not more than 4 corners, all in the same town and range, may be recorded on this certificate.

- A. Description of original monument and accessories and/or subsequent restoration:
 - GENERAL LAND OFFICE: NOT SET BY G.L.O.
 - COUNTY SURVEYOR DAVIS APRIL 1868 SHOWS STAKE FOR CORNER: ELM - N58W - 1/2.

- B. Description of corner evidence found and/or method applied in restoring or reestablishing corner:
 - PRELIMINARY FIELD CHECK: FOUND OLD 6" WOODEN FENCE CORNER; STANDING FENCES N. & W.; FOUND PLOW POINTS WEDGED AGAINST FENCE CORNER TO THE S. & E.
 - ACCEPTED FENCE CORNER AS BEST EVIDENCE OF CORNER POSITION.

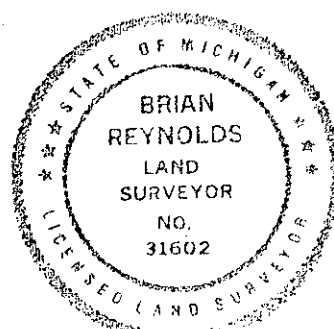

- C. Description of monument for corner and accessories established to perpetuate locating the position of the corner:
 - SET STANDARD EATON Co. REMON. IRON (3/4" x 24" WITH ORANGE PLASTIC CAP "PA345 #31602"); DIRECTLY ON OLD WOODEN 6" FENCE CORNER (ABOVE GROUND SECTION OF FENCE CORNER BROKEN AND LEANING), STANDING FENCES NORTH & WEST, PLOW POINTS WEDGED AGAINST FENCE CORNER SOUTH & EAST:
 - SET 5" SPIKE & ORANGE PLASTIC "REYNOLDS #31602" TAG - E. FACE - 16" ASH - N5E - 29.46'
 - SET 5" SPIKE & ORANGE PLASTIC "REYNOLDS #31602" TAG - N. FACE - 12" ELM - S80E - 13.02'
 - SET 5" SPIKE & ORANGE PLASTIC "REYNOLDS #31602" TAG - N. FACE - 10" ASH - N80W - 44.22'
 - SET 5" SPIKE & ORANGE PLASTIC "REYNOLDS #31602" TAG - NE. FACE - 5" ASH - N45W - 13.27'

Signed by [Signature] Date JULY 30, 1994
 Surveyor's Michigan License No. 31602