FILED
Copy

EATON COUNTY REMONUMENTATION

LAND CORNER RECORDATION CERTIFICATE 95 DEC 26 PM 2:30

Filing Requirement of Act 74, Mich. P.A. 1970

For corners in **EATON** (County)

	Located In:	Corner Code ##
1. Public Land Survey	T 4N R 6W	D-13
SUNFIELD TWSP.	T ___ R ___	
1/4 COR. SEC. 32	T ___ R ___	
ON TOWN LINE	T ___ R ___	
2. Property Controlling	S ___ T ___ R ___	
in Section	S ___ T ___ R ___	
3. Miscellaneous	S ___ T ___ R ___	
Property in Sec.	S ___ T ___ R ___	

LINDA M. TWITCHELL
REGISTER OF DEEDS
EATON COUNTY, MICH.

L.3 pg 668

Register of Deeds Stamp & File Number

4. Lot No. _____, Recorded Plat _____
5. Private Claims _____

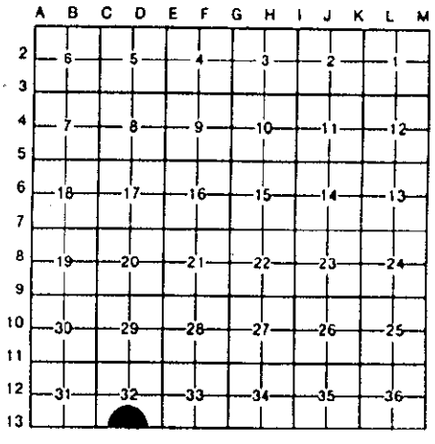

I, **BRIAN REYNOLDS**, in a field survey on **6 NOVEMBER 95**, 19 _____, do hereby certify that under requirements of P.A. 74, Michigan P.A. of 1970, the corner points mentioned in lines 1 and 2 above were in conformance with regulations and rules therefore as required in the current manual of survey instructions of the United States Department of the Interior, Bureau of Land Management or by a decree of a Court of Law and/or that the corner points mentioned in lines 3, 4 and 5 above were in conformance with the rules of the Michigan Board of Land Surveyors or by a Decree of a Court of Law; established, re-established, monumented, re-monumented, recovered, found as expressed below:

NOTE: Not more than 4 corners, all in the same town and range, may be recorded on this certificate.

A. Description of original monument and accessories and/or subsequent restoration:

1. GENERAL LAND OFFICE: LUCIUS LYON D.S., BEECH 18 N80E 25; BEECH 22 N39W 15
2. COUNTY SURVEYOR (DATED APRIL 1868, UNSIGNED, PROBABLY FRANK DAVIS, VOL 1, P. 16) SURVEY OF SECTION 32, NO MONUMENT OR WITNESSES NOTED, DISTANCE TO D-11 NOTED AS 79.99 CHAINS.

NO OTHER RECORD, PUBLIC OR PRIVATE, COULD BE FOUND FOR THIS CORNER

B. Description of corner evidence found and/or method applied in restoring or reestablishing corner:

NO EVIDENCE OF CORNER MONUMENT COULD BE FOUND. FOUND AN OCCUPATION LINE IN THE FORM OF A TREE ROW NORTH FROM KELLY HIGHWAY AT APPROXIMATE LOCATION OF 1/4 CORNER. TRAVERSED ENTIRE SECTION 32, TIED IN OCCUPATION LINES, DETERMINED BEST METHOD OF RESTORING CORNER WOULD BE SINGLE PROPORTION ON RESTORED TOWN LINE, AS DETERMINED BY RESTORED C-13 AND RESTORED E-13. SET STANDARD EATON COUNTY REMON IRON AND CAP IN MONUMENT BOX AT MID-POINT ON LINE, DISREGARDED OCCUPATION LINE. DISTANCE WEST TO C-13, 2644.09 FEET, DISTANCE EAST TO E-13, 2644.09 FEET.

C. Description of monument for corner and accessories established to perpetuate locating the position of the corner:

SET STANDARD EATON COUNTY REMON IRON AND PLASTIC CAP INSCRIBED "PA 345 31602" IN MON BOX
SET 20d NAIL W/PLASTIC TAG IN THE WEST SIDE OF A 12" CHERRY N17°W 52.75'
SET 20d NAIL W/PLASTIC TAG IN THE WEST SIDE OF A UTILITY POLE N25°E 125.36'
SET 20d NAIL W/PLASTIC TAG IN THE EAST SIDE OF A UTILITY POLE N49°W 176.43'
SET 20d NAIL W/PLASTIC TAG IN THE SOUTH SIDE OF A UTILITY POLE N68°E 308.63'
D-1 T3N, R6W, VERMONTVILLE TOWNSHIP, S89°32'E 19.37'
CENTERLINE OF BITUMINOUS ROAD EAST-WEST(KELLY HIGHWAY) NORTH 8'+/-
TREE LINE OCCUPATION RUNNING NORTH IS WEST 15'+/-

STATE OF MICHIGAN
BRIAN REYNOLDS
LAND SURVEYOR
NO. 31602
LICENSED LAND SURVEYOR

Signed by _____ Date 12/21/95

Surveyor's Michigan License No. 31602

P.A. 345 EATON COUNTY
PEER APPROVED 11/7/95 MW

FORM APPROVED BY MICHIGAN STATE BOARD OF LAND SURVEYORS, JAN. 28, 1971
REVISED MAY 14, 1975
REVISED JAN., 1983