

**SURVEY & REMONUMENTATION**

**EATON COUNTY REMONUMENTATION**

SEP 29 1994

**LAND CORNER RECORDATION CERTIFICATE**

Filing Requirement of Act 74, Mich. P.A. 1970

For corners in **EATON** COMMISSION

Located In: Corner Code ##

- 1. Public Land Survey T 4N R 6W E-9  
 T \_\_\_\_\_ R SUNFIELD TWSP.  
 T \_\_\_\_\_ R COR. SEC. 20,21,28 & 29  
 T \_\_\_\_\_ R \_\_\_\_\_
- 2. Property Controlling S \_\_\_\_\_ T \_\_\_\_\_ R \_\_\_\_\_  
 in Section S \_\_\_\_\_ T \_\_\_\_\_ R \_\_\_\_\_
- 3. Miscellaneous S \_\_\_\_\_ T \_\_\_\_\_ R \_\_\_\_\_  
 Property in Sec. S \_\_\_\_\_ T \_\_\_\_\_ R \_\_\_\_\_
- 4. Lot No. \_\_\_\_\_, Recorded Plat \_\_\_\_\_
- 5. Private Claims \_\_\_\_\_

FILED  
 Copy  
 94 AUG 18 PM 4:17  
 LINDA M. TWITCHELL  
 REGISTER OF DEEDS  
 EATON COUNTY, MICH.  
 LIBER 3 PG 440  
 Register of Deeds Stamp & File Number

	A	B	C	D	E	F	G	H	I	J	K	L	M
2	6		5		4		3		2		1		
3													
4	7		8		9		10		11		12		
5													
6	18		17		16		15		14		13		
7													
8	19		20		21		22		23		24		
9													
10	30		29		28		27		26		25		
11													
12	31		32		33		34		35		36		
13													

I, **BRIAN REYNOLDS**, in a field survey on **14 JULY**, 19 **94**, do hereby certify that under requirements of P.A. 74, Michigan P.A. of 1970, the corner points mentioned in lines 1 and 2 above were in conformance with regulations and rules therefore as required in the current manual of survey instructions of the United States Department of the Interior, Bureau of Land Management or by a decree of a Court of Law and/or that the corner points mentioned in lines 3, 4 and 5 above were in conformance with the rules of the Michigan Board of Land Surveyors or by a Decree of a Court of Law; established, re-established, monumented, re-monumented, recovered, found as expressed below:


**NOTE: Not more than 4 corners, all in the same town and range, may be recorded on this certificate.**

A. Description of original monument and accessories and/or subsequent restoration:

- GENERAL LAND OFFICE: ORANGE RISDON D.S., COPIED BY MORELL E. NEWCOMB, 01APR1908, SUGAR - 30 - N30E - 6, B.ASH - 12 - S39W - 27
- COUNTY SURVEYOR OSCAR C. CHURCH: FOUND STAKE SET BY DAVIS (NO DATE) 5 MAY 1874
- JAMES E. STEPHENS P.S. #16053, L.C.R.C. Lb. 2, Pg. 16; 24 JAN 1974; FOUND 3/4" PIPE AT INTERSECTION OF Mt. HOPE & IONIA ROADS. N&T - N. SIDE - 18" HICKORY - S65-27E - 59.45'  
 N&T - N. SIDE - 30" HICKORY - S57-36W - 101.20'  
 N&T - NE. SIDE - UTIL. POLE - N61-05W - 50.47'

B. Description of corner evidence found and/or method applied in restoring or reestablishing corner:

- PRELIMINARY FIELD CHECK: FOUND 3/4" PIPE IN MONUMENT BOX; STEPHENS' UTIL. POLE WITNESS GONE; STEPHENS' HICKORY WITNESSES PRESENT.
- ACCEPTED 3/4" PIPE IN MON. BOX AS PERPETUATION OF CORNER. SET STANDARD REMON. IRON (3/4" x 24" IRON WITH ORANGE PLASTIC CAP "PA345 #31602") IN MON. BOX.

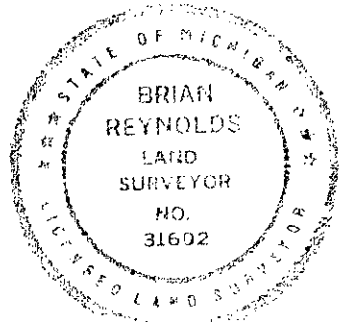

C. Description of monument for corner and accessories established to perpetuate locating the position of the corner:

- FOUND 3/4" PIPE IN MON. BOX. REPLACED PIPE WITH STANDARD EATON Co. REMON. IRON (3/4" x 24" WITH ORANGE PLASTIC CAP " PA 345 #31602 "):  
 FOUND NAIL - N. FACE - 18" HICKORY - S60E - 59.33'  
 SET 5" SPIKE & ORANGE PLASTIC "REYNOLDS #31602" TAG - N. FACE - 24" HICKORY - S70W - 101.20'  
 SET 5" SPIKE & ORANGE PLASTIC "REYNOLDS #31602" TAG - NE. FACE - 28" OAK - S50E - 42.74'  
 SET 5" SPIKE & ORANGE PLASTIC "REYNOLDS #31602" TAG - SW. FACE - 28" OAK - S22E - 55.55'  
 SET 5" SPIKE & ORANGE PLASTIC "REYNOLDS #31602" TAG - N. FACE - 22" HICKORY - S68E - 91.04'  
 SET 5" SPIKE & ORANGE PLASTIC "REYNOLDS #31602" TAG - NE. FACE - UTILITY POLE - N60W - 52.07'

Signed by Brian Reynolds Date JULY 27, 1994  
 Surveyor's Michigan License No. 31602

P.A. 345 EATON COUNTY  
 PEER APPROVED 7/27/94