

SEP 29 1994

COMMISSION EATON COUNTY REMONUMENTATION  
LAND CORNER RECORDATION CERTIFICATE  
Filing Requirement of Act 74, Mich. P.A. 1970

FILED

copy

94 AUG 18 PM 4: 18

LINDA M. TWITCHELL  
REGISTER OF DEEDS  
EATON COUNTY, MICH.

L.3 Pg 447  
Register of Deeds Stamp & File Number

corners in  
EATON  
(County)

Located In: Corner Code =#

Public Land Survey T 4N R 6W E-10  
T SUNFIELD TWSP.  
T 1/4 COR. SEC. 28 & 29  
T \_\_\_\_\_ R \_\_\_\_\_  
Property Controlling S \_\_\_\_\_ T \_\_\_\_\_ R \_\_\_\_\_  
in Section S \_\_\_\_\_ T \_\_\_\_\_ R \_\_\_\_\_  
Miscellaneous S \_\_\_\_\_ T \_\_\_\_\_ R \_\_\_\_\_  
Property in Sec. S \_\_\_\_\_ T \_\_\_\_\_ R \_\_\_\_\_


Lot No. \_\_\_\_\_, Recorded Plat \_\_\_\_\_  
Private Claims \_\_\_\_\_

BRIAN REYNOLDS, in a field survey on 14 JULY, 1994,  
hereby certify that under requirements of P.A. 74, Michigan P.A. of 1970, the corner points mentioned  
lines 1 and 2 above were in conformance with regulations and rules therefore as required in the  
current manual of survey instructions of the United States Department of the Interior, Bureau of Land  
Management or by a decree of a Court of Law and/or that the corner points mentioned in lines 3, 4 and 5  
above were in conformance with the rules of the Michigan Board of Land Surveyors or by a Decree of a  
Court of Law; established, re-established, monumented, re-monumented, recovered, found as  
expressed below:

**NOTE: Not more than 4 corners, all in the same town and range, may be recorded  
on this certificate.**

	A	B	C	D	E	F	G	H	I	J	K	L	M
2	6		5		4		3		2		1		
3													
4	7		8		9		10		11		12		
5													
6	18		17		16		15		14		13		
7													
8	19		20		21		22		23		24		
9													
10	30		29		28		27		26		25		
11													
12	31		32		33		34		35		36		

- Description of original monument and accessories and/or subsequent restoration:
- GENERAL LAND OFFICE: ORANGE RISDON D.S., COPIED BY MORELL E. NEWCOMB, 01APR1908, BEECH - 12
  - S56E - 11; Do. - 16 - N65W - 35
  - COUNTY SURVEYOR FRANK J. DAVIS: SET STONE, OCT. 1868
  - COUNTY SURVEYOR OSCAR C. CHURCH: FOUND STONE SET BY DAVIS, 5 MAY 1874

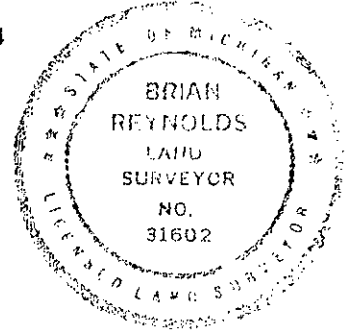

- Description of corner evidence found and/or method applied in restoring or reestablishing corner:
- PRELIMINARY FIELD CHECK: FOUND 1/2" CAPPED IRON "REM #26463"
  - UPON CONVERSING WITH RAY MOORED (PS# 26463), IT WAS UNDERSTOOD THAT THE 1/2" IRON FOUND HAD BEEN PLACED BY RAY MOORED OVER A FOUND STONE. EXCAVATION FOR MON. BOX PLACEMENT TURNED UP BRICK CIRCLED ABOUT WHERE STONE HAD BEEN. ACCEPTED 1/2" IRON AS PERPETUATION OF CHURCH'S (1874) CORNER POSITION.

- Description of monument for corner and accessories established to perpetuate locating the position of the corner:
- FOUND 1/2" IRON. REPLACED WITH STANDARD EATON Co. REMON. IRON (3/4" x 24" WITH ORANGE PLASTIC CAP "PA345 #31602"):  
NO AVAILABLE WIT. PRESENT:  
SET 1/2" IRON WITH ORANGE PLASTIC "REYNOLDS TRAV PT" CAP - N45W - 25.00'  
" " " " - N45E - "  
" " " " - S45W - "  
" " " " - S45E - "
  - E-10 TO E-9 MEASURES 2647.36'; E-10 TO D-10 MEASURES 2635.28'  
E-10 TO P.K. AT CENTERLINE/CENTERLINE SOUTH MEASURES 2644.49'

signed by [Signature] Date JULY 27, 1994  
Surveyor's Michigan License No. 31602