

DEC - 7 1998

EATON COUNTY REMONUMENTATION

FILED

Section

LAND CORNER RECORDATION CERTIFICATE
Filing Requirement of Act 74, Mich. P.A. 1970

copy
98 NOV 10 PM 12: 20

For Corners in EATON Located In: Corner Code #
(county)

1. Public Land Survey T 4N R 6W F-11
1/4 CORNER COMMON TO T _____ R _____
SECTIONS 28 & 33 T _____ R _____
SUNFIELD TOWNSHIP T _____ R _____

2. Property Controlling S _____ T _____ R _____
in Section S _____ T _____ R _____

3. Miscellaneous S _____ T _____ R _____

4. Lot No _____ Recorded Plat _____

5. Private Claims _____

LINDA M. TWITCHELL
REGISTER OF DEEDS
EATON COUNTY, MICH.

LIBER

3 PAGE 970

Register of Deeds Stamp & File Number

I, Brian Reynolds, in a field survey on 16 OCTOBER, 1998 do hereby certify that under requirements of P.A. 74, Michigan P.A. of 1970, the corner points mentioned in lines 1 and 2 above were in conformance with regulations and rules therefore as required in the current manual of survey instructions of the United States Department of the Interior, Bureau of Land Management or by a decree of a Court of Law and/or that the corner points mentioned in lines 3, 4, and 5 above were in conformance with the rules of the Michigan Board of Land Surveyors or by a Decree of a Court of Law; established, re-established, monumented, re-monumented, recovered, found as expressed below.

NOTE: Not more than 2 corners, all in the same town and range, may be recorded on this certificate.

	A	B	C	D	E	F	G	H	I	J	K	L	M
1													
2	6	5	4	3	2	1							
3													
4	7	8	9	10	11	12							
5													
6	18	17	16	15	14	13							
7													
8	19	20	21	22	23	24							
9													
10	30	29	28	27	26	25							
11													
12	31	32	33	34	35	36							
13													

A. Description of original monument and accessories and/or subsequent restoration:

- GENERAL LAND OFFICE: ORANGE RISDON, D.S., 1827 (R6W, P. 625) "WEST CORRECTED ... 39.70 SET 1/4 SEC POST BEECH 10 N81E 16 SUGAR 18 S81W 3
- COUNTY SURVEYOR RECORDS: NO NAME OR DATE (V.1, P.17) "STONE" NO WITNESSES GIVEN
- COUNTY SURVEYOR RECORDS: NO NAME OR DATE (V.1, P.30) "STONE" NO WITNESSES GIVEN MARGINAL NOTE BY FRANK DAVIS "THE S.E. CORNER OF 28 IS NOT CORRECT- I HAVE SINCE FOUND THE OLD GOV'T POST"
- PRIVATE NOTES OF RAY MOORED, P.S. #26463, 4-8-93, WORKING IN THE SOUTHWEST 1/4 OF SECTION 28, NOTES SHOW MOORED USED A COMPUTED POINT FOR F-11, WITH DISTANCES TO E-11 AS 2633.06 & G-11 AS 2630.00. NO MONUMENT SET
- PRIVATE NOTES OF LARRY BRYAN, P.S. #25832, JOB #97-B-53994, c.1997, WORKING IN THE SOUTHEAST 1/4 OF SECTION 33 NOTES SHOW A COMPUTED POSITION FOR F-11 HOLDING A FENCE POST SOUTH OF BISMARCK HIGHWAY FOR 1/4 LINE, NO MONUMENT SET.


B. Description of corner evidence found and/or method applied in restoring or reestablishing corner:

FOUND NO MAGNETIC EVIDENCE OF CORNER MONUMENTATION. FOUND FENCE POST SOUTH OF ROAD (USED BY BRYAN, #5 ABOVE): FOUND FENCE POST LIES 13.08 FEET EAST OF THE MID-POINT BETWEEN E-11 & G-11. EXCAVATED A 2' X 2' AREA CENTERED ON THE COMPUTED MID-POINT. AT A DEPTH OF 18" FOUND AN 8" X 10" X 10" POINTED STONE SURROUNDED BY 4 SMALLER STONES (6" - 8"). FOUND STONE IN CIRCLE OF SMALLER STONES LIES 0.02' WEST OF THE MID POINT BETWEEN E-11 AND G-11, AND 0.88' SOUTH OF A LINE BETWEEN E-11 AND G-11. ACCEPTED FOUND POINTED STONE IN CIRCLE OF STONES AS BEST AVAILABLE EVIDENCE OF CORNER POSITION. REPLACED FOUND POINTED STONE IN CIRCLE OF STONES WITH STANDARD EATON COUNTY REMONUMENTATION MONUMENT WITH ALUMINUM CAP STAMPED "31602" & INSTALLED MONUMENT BOX.

C. Description of monument for corner and accessories established to perpetuate locating the position of the corner:

SET STANDARD EATON COUNTY REMONUMENTATION MONUMENT (3/4" X 36" IRON) WITH ALUMINUM CAP IN MONUMENT BOX.

- SET 20d NAIL W/PLASTIC TAG IN THE EAST SIDE OF A 4" WALNUT N10°W 44.24'
- SET 20d NAIL W/PLASTIC TAG IN THE NORTHWEST SIDE OF A 43" WALNUT N53°E 60.94'
- SET 20d NAIL W/PLASTIC TAG IN THE NORTH SIDE OF A UTILITY POLE S82°E 205.48'
- SET 20d NAIL W/PLASTIC TAG IN THE NORTH SIDE OF A UTILITY POLE S56°E 231.66
- SOUTHEAST CORNER OF A 4' X 4' CONCRETE FIELD DRAIN CATCH BASIN N71°E 72.33'
- SET 20d NAIL W/PLASTIC TAG IN THE NORTH SIDE OF A UTILITY POLE S49°W 199.28'
- 3.6'+/- SOUTH OF PAINTED EAST-WEST CENTERLINE
- REMONUMENTED E-11 LIES N89°16'29"W 2632.07'
- REMONUMENTED G-11 LIES S89°18'47"E 2632.09'

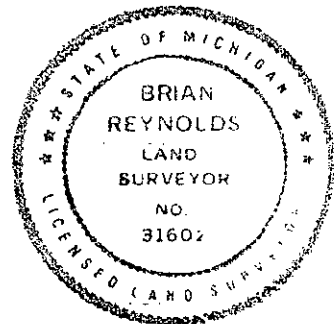

P.A. 345 EATON COUNTY
PEER APPROVED 6/23/98

Signed by [Signature]
Surveyor's Michigan License No 31602

Date 11-2-1998