

SURVEY & REMONUMENTATION

DEC 3 1999

SECTION

EATON COUNTY REMONUMENTATION

FILED

Copy

LAND CORNER RECORDATION CERTIFICATE

Filing Requirement of Act 74, Mich. P.A. 1970

99 DEC -3 PM 4: 15

LINDA M. TWITCHELL
REGISTER OF DEEDS
EATON COUNTY, MICH.

LIBER

4 PAGE 114

Register of Deeds Stamp & File Number

	A	B	C	D	E	F	G	H	I	J	K	L	M
1													
2	6	5	4	3	2	1							
3													
4	7	8	9	10	11	12							
5													
6	18	17	16	15	14	13							
7													
8	19	20	21	22	23	24							
9													
10	30	29	28	27	26	25							
11													
12	31	32	33	34	35	36							
13													

For Corners in EATON (county)

Located In: Corner Code #

1. Public Land Survey
CORNER COMMON TO
SECTIONS 33 & 34
SUNFIELD TOWNSHIP
ON TOWNSHIP LINE

2. Property Controlling
in Section

3. Miscellaneous

4. Lot No _____, Recorded Plat _____

5. Private Claims _____

T 4N R 6W G-13

T _____ R _____

T _____ R _____

T _____ R _____

S _____ T _____ R _____

S _____ T _____ R _____

S _____ T _____ R _____


I, Brian Reynolds, in a field survey on 9 JULY, 1999 do hereby certify that under requirements of P.A. 74, Michigan P.A. of 1970, the corner points mentioned in lines 1 and 2 above were in conformance with regulations and rules therefore as required in the current manual of survey instructions of the United States Department of the Interior, Bureau of Land Management or by a decree of a Court of Law and/or that the corner points mentioned in lines 3, 4, and 5 above were in conformance with the rules of the Michigan Board of Land Surveyors or by a Decree of a Court of Law; established, re-established, monumented, re-monumented, recovered, found as expressed below.

NOTE: Not more than 2 corners, all in the same town and range, may be recorded on this certificate.

- A. Description of original monument and accessories and/or subsequent restoration:
- GENERAL LAND OFFICE: ORANGE RISDON, D.S., 1827 (R6W, P.566) "WEST ON S. BDY SEC. 34 T4N, R6W...80.00 SET POST COR. SECT. 33 & 34" BEECH 18 N26E 9 Do. 12N81W 17
 - COUNTY SURVEYOR RECORDS: OSCAR CHURCH, 2 MARCH, 1874 (V.1, P.194-195) "STONE" NO WITNESSES GIVEN
 - LAND CORNER RECORDATION CERTIFICATE: BY LARRY A. BRYAN, P.S., #25832, 18 JUNE, 1997 (L.3, 781) "FOUND 1/4" PIPE 6" BELOW ASPHALT +/- 1' SOUTH OF CENTERLINE OF KELLY HIGHWAY, +/- 3' EAST OF CENTERLINE OF ROUND LAKE ROAD TO SOUTH. CORNER APPEARS TO BE G-1 FOR T3N, R6W, VERMONTVILLE TOWNSHIP. MEASURED EAST TO I-1 5258.58' AS RECORDED IN LIBER 2, PAGE 86 & MET CLOSELY WITH 1/8 LINE FENCE TO SOUTH. THEREFORE HELD 1/4" PIPE AS CORRECT LOCATION FOR G-1 & SET BAR & CAP #25832 AT RECORDED G.L.O. DISTANCE OF 62.70' WEST FOR LOCATION OF G-13, T4N, R6W, SUNFIELD TOWNSHIP. BAR & CAP SET ON LINE WITH G-1 & E-13 AS RECORDED IN LIBER 3, PAGE 230 OF T4N, R6W. NORTH-SOUTH 1/4 LINE FENCE & NORTH-SOUTH 1/8 LINE FENCE OF SOUTHEAST 1/4 MET CLOSELY WITH SET BAR & CAP. FOUND 1/2" BAR, EAST 62.70' SET NAIL & TAG EAST SIDE 6" PINE N35°W 78.23' SET NAIL & TAG SOUTHEAST SIDE POWER POLE N45°E 64.00' SET NAIL & TAG WEST SIDE ELM CLUSTER N30°E 94.61'
 - ACT 132 SURVEY: BY LARRY A. BRYAN, P.S., #25832, 29 MAY, 1997 (L.7, P.111-113) RECITE SAME WITNESSES AS IN #3 ABOVE

B. Description of corner evidence found and/or method applied in restoring or reestablishing corner:
FOUND 1/2" IRON WITH CAP BY BRYAN. WITNESSES FOUND WERE THE PINE, UTILITY POLE & G-1 (T3N, R6W) (ITEMS #3 & #4 ABOVE). EXCAVATION AROUND BRYAN IRON REVEALED A 2" X 8" PIPE WITH A POINTED IRON STAKE INSIDE, LEANING WEST APPROXIMATELY 3' BELOW ROAD GRADE. 1± UNDER PIPE WAS AN 8" X 8" ROUND STONE SURROUNDED BY SMALLER STONES. IRON BY BRYAN WAS 0.8± EAST OF FOUND PIPE/STONE. ACCEPTED FOUND STONE AS PERPETUATION OF CORNER BY COUNTY SURVEYOR OSCAR CHURCH. REPLACED FOUND STONE WITH STANDARD EATON COUNTY MONUMENT AND INSTALLED MONUMENT BOX.

C. Description of monument for corner and accessories established to perpetuate locating the position of the corner:
SET STANDARD EATON COUNTY REMONUMENTATION MONUMENT (3/4" X 36" IRON) WITH ALUMINUM CAP. INSTALLED MONUMENT BOX.
FOUND NAIL & TAG IN THE EAST SIDE OF AN 8" PINE N25°W 78.35'
"X" IN THE SOUTH END OF A 10" CMP CULVERT S52°W 37.71'
FOUND NAIL & TAG IN THE SOUTHEAST SIDE OF A UTILITY POLE N58°E 64.80'
A-1 (T3N, R6W) LIES EAST 63.49'
CORNER LIES ROUGHLY ON CENTERLINE

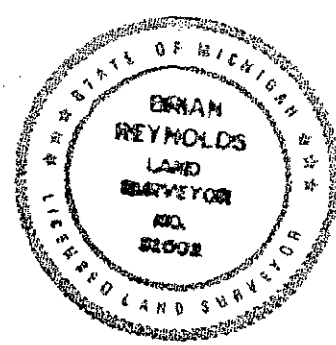

Signed by [Signature]
Surveyor's Michigan License No 31602

Date DEC 3, 1999

FORM APPROVED BY MICHIGAN STATE BOARD OF LAND SURVEYORS. JAN. 28, 1971
REVISED MAY 14, 1975 REVISED JANUARY, 1983 REVISED OCTOBER 1985

P.A. 345 EATON COUNTY
PEER APPROVED 7/14/99 AL