

MICHIGAN
DEPARTMENT OF CONSERVATION
FORESTRY DIVISION


LAND CORNER RECORD

T. 34 N.R. 4 W

Emmet COUNTY

DESCRIPTION OF CORNER Section corner common to Sections 31 - 32 on south
boundary of township.
CORNER MONUMENT 1" pipe with 4" aluminum cap.
DATE MONUMENT PLACED AND WITNESSED 12-6-61

WITNESSES TO CORNER.....

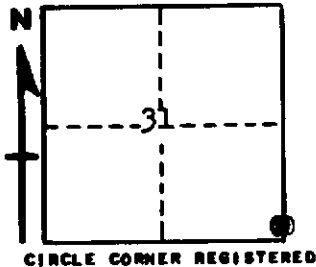

20" W. Pine - N 31 W - 12.8 feet
5" Cedar - N 88 E - 23.6 feet

AND

DESCRIPTION IN DETAIL AS TO HOW CORNER WAS LOCATED AND IDENTIFIED OR RESTORED.

This corner was found while making a survey in T33N R4W. Found 1-1/4" pipe with concrete base in place, as established by Marcus Schaaf, R.L.S., in previous survey in this area. Claimed to have been restored from original evidence by former Forestry Division personnel. Checks with old fence line from the north, and checks okay to town corner west, although the mile east is considerably short of record. Considered best available evidence.

Corner to Sections 5 and 6, T33N R4W, is 35 links west.

SURVEYOR'S SEAL

SIGNED *Kenneth J. Oetting* DATE 12/12/61
REGISTERED LAND SURVEYOR