

SURVEY & REMONUMENTATION

APR 27 1995

COMMISSION

LAND CORNER RECORDATION CERTIFICATE
Filing Requirement of Act 74, Mich. P.A. 1970

LIBER A
PAGE 34

STATE OF MICHIGAN
EMMET COUNTY
RECORDED

1994 DEC -7 AM 11:10

Glenn D. Sizer
REGISTER OF DEEDS

Register of Deeds Stamp & File Number

For corners in

<u>EMMET</u> (County)	Located In:	Corner Code #
1. Public Land Survey	T <u>34N</u> R <u>5W</u>	<u>G12</u>
	T _____ R _____	_____
	T _____ R _____	_____
	T _____ R _____	_____
2. Property Controlling in Section	S _____ T _____ R _____	_____
	S _____ T _____ R _____	_____
3. Miscellaneous Property in Sec.	S _____ T _____ R _____	_____
	S _____ T _____ R _____	_____

4. Lot No. _____, Recorded Plat _____
5. Private Claims _____

A	B	C	D	E	F	G	H	I	J	K	L
2	6	5	4	3	2	1					
3											
4	7	8	9	10	11	12					
5											
6	16	17	18	15	14	13					
7											
8	19	20	21	22	23	24					
9											
10	30	29	28	27	26	25					
11											
12	31	32	33	34	35	36					
13											

I, Thomas D. Swenor in a field survey on March, 19 94, do hereby certify that under requirements of P.A. 74, Michigan P.A. of 1970, the corner points mentioned in lines 1 and 2 above were in conformance with regulations and rules therefore as required in the current manual of survey instructions of the United States Department of the Interior, Bureau of Land Management or by a decree of a Court of Law and/or that the corner points mentioned in lines 3, 4 and 5 above were in conformance with the rules of the Michigan Board of Land Surveyors or by a Decree of a Court of Law; established, re-established, monumented, re-monumented, recovered, found as expressed below:

NOTE: Not more than 4 corners, all in the same town and range, may be recorded on this certificate.

A. Description of original monument and accessories and/or subsequent restoration:

E12
SEE BACK PAGE OF THIS FORM FOR CHRONOLOGY

B. Description of corner evidence found and/or method applied in restoring or reestablishing corner:

E12
1994 went to Found Ford Axel Shaft of above referenced Liber 3, Page 52 Land Corner Recordation Certificate. Searched for GLO corner, (6 inch spruce), did not find. Rechecked witnesses of above corner record. Distances and Bearings check with previous measurement. See below.

THIS CORNER IS ACCEPTED BY THE EMMET COUNTY REMONUMENTATION GROUP AS A FAITHFUL AND CAREFUL PERPETUATION OF THE ORIGINAL CORNER.


APPROVED LAND CORNER
P.A. 345 OF 1990
Emmet County
R.E. DeVe P.S. Co. Rep.
21 Nov. 1994

C. Description of monument for corner and accessories established to perpetuate locating the position of the corner:

E12
Found Ford Axel Shaft as referenced in Liber 3, Page 52, and replaced with a 2" diameter, 30" long PVC Pipe with a Base magnet and a standard brass Emmet County Remonumentation cap.

Witnesses:

- 15" White Pine - N60°E 5.86 feet (spike nail with cap 37282 in the north face of the tree)
- 4" Ash - N10°E 8.37 feet (spike nail with cap 37282 in the west face of the tree)
- 6" Cedar - S30°W 4.42 feet (spike nail with cap 37282 in the southeast face of the tree)
- 7" White Pine - S45°E 13.40 feet (spike nail with cap 37282 in the east face of the tree)

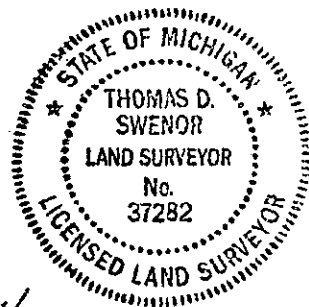

Signed by Thomas D. Swenor
Surveyor's Michigan License No. 37282

Date 11-22-94

A. DESCRIPTION OF ORIGINAL MONUMENT AND ACCESSORIES AND/OR SUBSEQUENT RESTORATION

E-4

<u>Date</u>	<u>Surveyor</u>	<u>Found</u>	<u>(Witnesses)</u>
1840	GLO	A spruce 6i the gr. post	
1890	Keep	1/4 Post E. side Section 33	47.19 Ft S 25.59 Ft. E
1903	Palmer	Cedar P 7	
1992	Thomas D. Swenor	Ford Axel Shaft	15" White Pine N60°E 5.86' 4" Ash N10°E 8.37' 6" Cedar S30°W 4.42' 7" White Pine S45°E 13.40'

Corner recorded by Thomas D. Swenor in Liber 3, Page 52, Emmet County Records as stated in L.C.R.C.... On June 23, 1992 I talked to Rose Barnes regarding if she knew of the location of the E 1/4 Corner of Section 33, T34N R5W, Corner being the Southeast corner of her 80 Acres. She stated "My husband, (now deceased), placed a ford axel shaft at an old rotten post 40+ years ago." With her nephew, Midge Barnes, we went to the location she talked of, (On top of a ridge, near a stone used to salt livestock). We found ford axel shaft in the vicinity above discussed.