

MAR 04 1998

STATE OF MICHIGAN
EMMET COUNTY
RECORDED

97 DEC 29 PM 3:10

SECTION

LAND CORNER RECORDATION CERTIFICATE

Filing Requirement of Act 74, Mich. P.A. 1970

Glenn A. Lipe

REGISTER OF DEEDS

For corners in

Emmet
(County)

Located In:

Corner Code #

1. Public Land Survey

T 34N R 6W

J-5

ECRP #153

T ___ R ___
T ___ R ___
T ___ R ___

2. Property Controlling in Section

S ___ T ___ R ___
S ___ T ___ R ___

3. Miscellaneous Property in Sec.

S ___ T ___ R ___
S ___ T ___ R ___

4. Lot No. _____, Recorded Plat _____
5. Private Claims _____

LIBER A

PAGE 219

Register of Deeds Stamp & File Number

Thomas D. Swenor in a field survey on 12/05, 19 97, do hereby certify that under requirements of P.A. 74, Michigan P.A. of 1970, the corner points mentioned in lines 1 and 2 above were in conformance with regulations and rules therefore as required in the current manual of survey instructions of the United States Department of the Interior, Bureau of Land Management or by a decree of a Court of Law and/or that the corner points mentioned in lines 3, 4 and 5 above were in conformance with the rules of the Michigan Board of Land Surveyors or by a Decree of a Court of Law, established, re-established, monumented, re-monumented, recovered, found as expressed below:

	A	B	C	D	E	F	G	H	I	J	K	L	M
2	6		5		4		3		2		1		
3													
4	7		8		9		10		11		12		
5													
6	18		17		16		15		14		13		
7													
8	19		20		21		22		23		24		
9													
10	30		29		28		27		26		25		
11													
12	31		32		33		34		35		36		
13													

NOTE: Not more than 4 corners, all in the same town and range, may be recorded on this certificate.

A. Description of original monument and accessories and/or subsequent restoration:

J-5,
Quarter (1/4) Corner common to Section 11, and Section 14, T34N R6W
(SEE BACK OF PAGE FOR HISTORY)

B. Description of corner evidence found and/or method applied in restoring or reestablishing corner:

J-5,
Found T-Iron as set by James H. Green in 1981, (see Liber 2 Page 78, LCRC). From found T-Iron measured in the Southeast Quadrant and found a 10" Elm stump. The 10" Elm stump measured 62.5 +/- (See witness (3) on reverse side for comparison to ECRC measurement). Did not find either the maple clump, (4), or Elm clump, (5). Extensive cut and fill has occurred at this intersection. Found T-Iron is in the centerline of Blackbird Road, (north/south), and Sterzik Road, (east/west). T-Iron harmonizes very well with fence lines in the Northwest and Northeast Quadrants.


THIS CORNER IS ACCEPTED BY THE EMMET COUNTY REMONUMENTATION GROUP AS A FAITHFUL AND CAREFUL PERPETUATION OF THE ORIGINAL CORNER.

APPROVED LAND CORNER
P.A. 345 OF 1990
Emmet County
P.E. DeLoo
ECRP Rep
12-30-97

C. Description of monument for corner and accessories established to perpetuate locating the position of the corner:

J-5,
Found T-Iron as recorded in Liber 2, Page 78, Land corner recordation certificate and replaced with a 2" diameter, 30" long PVC Pipe with a base magnet and a standard brass Emmet County Remonumentation Cap.

- Witnesses:
- (10) S39°E 46.40' - Power Pole (set spike nail with 37282 cap)
 - (11) S49°W 42.51' - Power Pole (set spike nail with 37282 cap)
 - (12) N39°W 41.70' - Power Pole (set spike nail with 37282 cap)
 - (13) S26°E 70.66' - 14" Maple (set spike nail with 37282 cap)

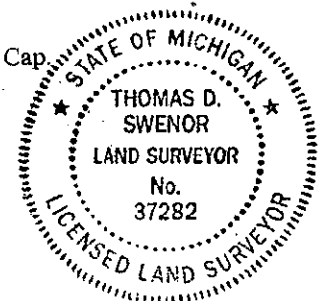

Signed by Thomas D. Swenor

Date 12/29/97

#153, 34-6 J-5

A. DESCRIPTION OF ORIGINAL MONUMENT AND ACCESSORIES AND/OR SUBSEQUENT RESTORATION:

Date	Surveyor	Found	(Witnesses)	
1840	GLO	Set Qr. Sec. Post	(1)	Sugar 4 N18E 16
			(2)	Ironwood 5 S80E 14
1887	J. Keep	Establish 1/4 Post Between Sec. 11 & 14 Placed charcoal & Lrg. stone with cross		
1906	F.T. Williams	Shows 1/4 Post at Road Intersection		
1962	G.E. Young	Shows distance of mile through corner # 153		
1965	E.C.R.C.	Found 1" Solid Iron Rod Set Monument Box	(3) (4) (5)	S.E. 62.45' - 10" Elm E.S.E. 57.95' - Maple clump S.W. 29.95' - Elm Clump
1981	J.H. Green	Set T-Iron (L. 2, P. 78, LCRC) Set at single proportion meas.	(6) (7) (8)	S71E 83.33' - Power Pole S49E 60.99' - 4" Aspen S26E 69.93' - 3" Maple
1989	J.H. Green	Found T-Iron	(6) (7) (8) (9)	S71E 83.33' - Power Pole S49E 60.99' - 4" Aspen S26E 69.93' - 3" Maple S45E 46.67' - 1/2" re-rod (15401)

note: Between 1965 ECRC and 1981 Green survey the intersection of Sterzik and Blackbird Road was cut. The corner as found in 1965 appears to have been obliterated during construction.

SURVEY &
REMONUMENTATION

MAR 04 1998

SECTION