

MAY 05 1997

COMMISSION

LAND CORNER RECORDATION CERTIFICATE
Filing Requirement of Act 74, Mich. P.A. 1970

STATE OF MICHIGAN
EMMET COUNTY
RECORDED
95 DEC 31 PM 2:25

For corners in

Emmet
(County)

Located In:

Littlefield Township

Corner Code #

- 1. Public Land Survey T 35N R 4W C-5
 ECRP #130
 T _____ R _____
 T _____ R _____
 T _____ R _____
- 2. Property Controlling in Section S _____ T _____ R _____
 S _____ T _____ R _____
- 3. Miscellaneous Property in Sec. S _____ T _____ R _____
 S _____ T _____ R _____


Alma L. Siga
REGISTER OF DEEDS

LIBER A
PAGE 117

Register of Deeds Stamp & File Number

- 4. Lot No. _____, Recorded Plat _____
- 5. Private Claims _____

I, Michael A. Trowbridge, in a field survey on December 11, 1996, do hereby certify that under requirements of P.A. 74, Michigan P.A. of 1970, the corner points mentioned in lines 1 and 2 above were in conformance with regulations and rules therefore as required in the current manual of survey instructions of the United States Department of the Interior, Bureau of Land Management or by a decree of a Court of Law and /or that the corner points mentioned in lines 3, 4 and 5 above were in conformance with the rules of the Michigan Board of Professional Surveyors or by a Decree of a Court of Law; established, re-established, monumented, re-monumented, recovered, found as expressed below:

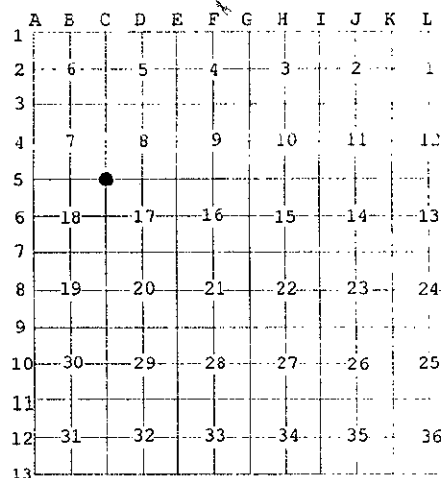

NOTE: Not more that 4 corners, all in the same town and range, may be recorded on this certificate.

A. Description of original monument and accessories and/or subsequent restoration:

C-5..... Corner common to Sections 7, 8, 17 & 18, T35N, R4W

See corner chronology on back side of this page.

APPROVED LAND CORNER
P.A. 345 OF 1990
Emmet County
R.R. OELKE
12-30-96


B. Description of corner evidence found and/or method applied in restoring or reestablishing corner:

C-5..... Corner common to Sections 7, 8, 17 & 18, T35N, R4W

Found 5/8" diameter x 9" long rerod over 7/8" diameter x 20" long rerod.

Found Witnesses

- 3) S35°E 49.50' 10" Twin Maple (spike in west face)
- 4) S14°E 53.45' 10" Ash (spike in west face)
- 5) North 33.00' T-iron
- 7) N5°E 31.75' "X" in southwest MBT pedestal
- 8) N75°E 90.41' 3" Maple (spike in southeast face)

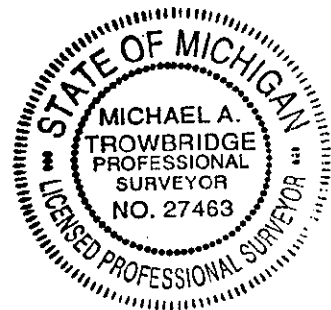

C. Description of monument for corner and accessories established to perpetuate locating the position of the corner:

C-5..... Corner common to Sections 7, 8, 17 & 18, T35N, R4W

The 5/8" and 7/8" rerods were removed and replaced with a 2" diameter x 30" long PVC pipe, a base magnet and a standard brass Emmet County Remonumentation cap. A standard monument box was placed over the new monument, set flush with the paved road surface. This position is accepted as a careful and faithful perpetuation of the original corner.

New Witnesses

- 3) S35°E 49.50' 10" Twin Maple (spike in west face) added 27463 cap above found spike
- 4) S14°E 53.45' 10" Ash (spike in west face) added 27463 cap above found spike
- 8) N75°E 90.41' 3" Maple (spike in southeast face) added 27463 cap at same position

Signed by Michael A. Trowbridge Date December 19, 1996
Surveyor's Michigan License No. 27463

A. DESCRIPTION OF ORIGINAL MONUMENT AND ACCESSORIES AND/OR SUBSEQUENT RESTORATION:

Date	Surveyor	Found	(Witnesses)
1840	GLO	Set Post	(1) Beech 7 N25W 29 (2) Beech 8 N44E 35
1888	J.Keep	Measure from N.W. Corner Sec. 18, T35N R4W	no witnesses
1897	J.Keep	Measure from S.E. Corner Section 7, T35N R4W	no witnesses
1917	T.W. Wilcoxon	Shows circle on map	Liber 1, Page 308, 309, County Surveyor Book
circa 1960	E.C.R.C.	Found cedar stake and stones/Set 3/4" iron re-rod	(3) S35°E 50.10' - (2)8" Twin Maple (4) S05°E 53.50' - (2)8" Ash (Fence line north and south, and road c/l east and west)
1966	G.E. Young	Witnessed fence corner	Fence Line Survey, no reference to corner set or found N.E. Cor to N. 1/4 Cor (meas. 2576')
1971	R.E. Bidstrup	Found 3/4" rod	No Wit's. N.E. to N 1/4 (meas. 2578')
1976	R.E. Bidstrup	Found 5/8" rod (L. 1, P. 221, LCRC)	(3) S35°E 50.10' - (2)8" Twin Maple (4) S05°E 53.50' - 8" Ash
1976	G.E. Young	Found 1/2" Iron Bar	(5) North 33.' Set T-Iron stake on R/W
1978	G.E. Young	Found survey point	(5) North 33.' Found T-Iron stake on R/W
1978	J.H. Green	Found 3/4" re-rod	(3) S35°E 50.10' - (2)8" Twin Maple (4) S05°E 53.50' - (2)8" Ash
1980	J.H. Green	Found 3/4" re-rod (L.2, P.67, LCRC)	(3) S35°E 50.10' - (2)8" Twin Maple (4) S05°E 53.50' - (2)8" Ash
1984	M.A. Trowbridge	Found 5/8" re-rod	(3) S35°E 50.10' - (2)8" Twin Maple (4) S05°E 53.50' - (2)8" Ash
1987	M.A. Trowbridge	Found 5/8" re-rod	(3) S40°E 49.60' - 9" Twin Maple (4) S14°E 53.45' - 10" Ash (5) North 33.00' -T-Iron (6) South 33.00' -5/8" Re-Rod
1990	M.A. Trowbridge	Found 5/8" re-rod	(3) S40°E 49.60' - 9" Twin Maple (4) S14°E 53.45' - 10" Ash (5) North 33.00' -T-Iron (6) South 33.00' -5/8" Re-Rod
1990	R.E. Oelke	Found 5/8" Rod	Recorded in L. 2, P67, LCRC
1992	R.E. Oelke	Found 5/8" Rod (L.3, P.32 LCRC)	(7) N05°E 31.75' - "X" in SW MBT Ped. (4) S05°E 53.40' -8" Ash (3) S35°E 49.50' - (2)10" Maple (8) N75°E 90.41' - 3" Maple (tag 33983)
1995	M.A. Trowbridge	Found 5/8" re-rod	(3) S40°E 49.60' - 9" Twin Maple (4) S14°E 53.45' - 10" Ash (5) North 33.00' -T-Iron (6) South 33.00' -5/8" Re-Rod