

LAND CORNER RECORDATION CERTIFICATE


Filing Requirement of Act 74, Mich. PA 1970

	Survey	Located In	Corner Code #
	controlling	T 35N R 4W T 35N R 4W	A-2 A-3
	Previous in Section	S T R S T R S T R S T R	
Claims:		Recorded Plat: _____	

Kiiskila, in a field survey on May 6, 1998 do hereby state that under sections of PA 74, Michigan PA of 1970, the corner points mentioned in lines 1 above were in conformance with regulations and rules therefore as required in current manual of survey instructions of the United States Department of the Bureau of Land Management or by a decree of a Court of Law and/or that the points mentioned in lines 3, 4 and 5 above were in conformance with the rules Michigan Board of Land Surveyors or by a Decree of a Court of Law; re-established, monumented, recovered, found as expressed below:

Not more than 2 corners, all in the same town and range, may be recorded on this certificate.

Register of Deeds Stamp & File Number

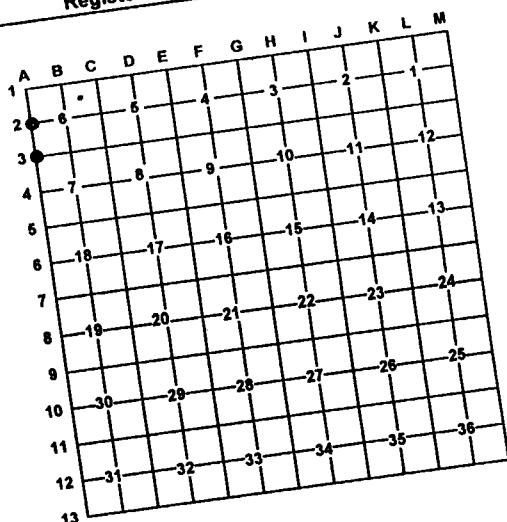

Description of original monument and accessories and/or subsequent restoration:

A-2 G.L.O. - John Mullett, D.S.-May 1840
Set quarter section post
Wit: Beech 12"
Sugar 14"

N 27° E 31 links
S 26° W 18 links

A-3 G.L.O. - John Mullett ,D.S.- May 1840
Set section post
Wit : Beech 9"
Hemlock 12" S72°W N28°E 28 links
13 links

B. Description of corner evidence found and/or method applies in restoring or re-establishing corner:
A-2 Re-established the west quarter corner of section 6
online between corners A-3 and A-1 prorated to U.S. run out.

A-3 Re-established the southwest corner of section 6 by single proportionate measurement between corners A-2 and A-4.

C. Description of monument for corner and accessories established to perpetuate locating the position of the corner:
A-2 Set 1X32 iron pipe with aluminum DNR cap and Carsonite post.
Wit: 12" Beech N 31° E 14.84'
6" Beech N 41° W 11.10'
9" Maple S 23° W 32.56'
22" Beech S 67° E 20.33'
"T" iron S 89° W 11.10'

A-3 Set 1X32 iron pipe with aluminum DNR cap and Carsonite post.
Wit: 8" Maple N83°E 13.73'
8" Beech N01°W 31.53'
6" Beech S43°W 13.33'
6" Maple N88°W 27.23'

Signed by:

Carl T Kiiskila

33981

Surveyor's Michigan License No.:

Date:

9-29-99

FORM APPROVED BY MICHIGAN STATE BOARD OF PROFESSIONAL SURVEYORS JAN. 28, 1971
Revised May 14, 1975
Revised Jan. 1983
Revised Oct. 1995

