


# LAND CORNER RECORDATION CERTIFICATE

Filing Requirement of Act 74, Mich. PA 1970

Corner In:	Located In	Corner Code #
Public Land Survey	T 35N R 4W	B-4
Property Controlling in Section	S 6 T 35N R 4W	2
Miscellaneous Property in Section	S T R	
	S T R	

Register of Deeds Stamp & File Number

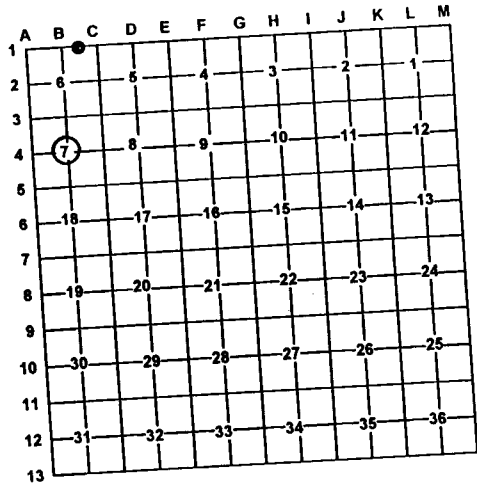

I, Carl T. Kiiskila, in a field survey on May 6, 1998 do hereby state that under requirements of PA 74, Michigan PA of 1970, the corner points mentioned in lines 1 and 2 above were in conformance with regulations and rules therefore as required in the current manual of survey instructions of the United States Department of the Interior, Bureau of Land Management or by a decree of a Court of Law and/or that the corner points mentioned in lines 3, 4 and 5 above were in conformance with the rules of the Michigan Board of Land Surveyors or by a Decree of a Court of Law; established, re-established, monumented, recovered, found as expressed below:

**NOTE: Not more than 2 corners, all in the same town and range, may be recorded on this certificate.**

A. Description of original monument and accessories and/or subsequent restoration:  
 B-4 This corner was not established during the original government survey.      2- This corner was not established during the original government survey.

B. Description of corner evidence found and/or method applies in restoring or re-establishing corner:  
 B-4 Established the center of section 7 at the intersection of the North-South and East-West quarter lines.      2 Established the northeast corner of the northwest quarter of the northeast quarter of section 7 per standard BLM instructions for the subdivision of a section.

C. Description of monument for corner and accessories established to perpetuate locating the position of the corner:  
 B-4 Set 5/8" x 32" rerod with PS cap and carsonite post.      2 Set 5/8"X32" rerod with PS cap  
 Wit: 16" Twin Maple S 56° E 24.53'      4" Elm N17°E 38.09'  
      20" Maple S 24° W 36.94'      5" Cherry S42°W 35.02'  
      3" Beech N 13° W 42.58'      8" Scotch pine S09°E 43.74'  
      8" Maple N 42° E 61.97'      6" Cherry S55°E 37.03'  
      Old east-west fence south 58.5'

Signed by: Carl T. Kiiskila  
 Surveyor's Michigan License No.: 33981

Date: 9-29-99

