


LAND CORNER RECORDATION CERTIFICATE
Filing Requirement of Act 74, Mich. PA 1970

For Corners In: Emmet (County)	Located In	Corner Code #
1. Public Land Survey	T _____ R _____	_____
	T _____ R _____	_____
2. Property Controlling in Section	S <u>18</u> T <u>36N</u> R <u>4W</u>	<u>10</u>
	S _____ T _____ R _____	_____
3. Miscellaneous Property in Section	S _____ T _____ R _____	_____
	S _____ T _____ R _____	_____
4. Lot No: _____	Recorded Plat: _____	
5. Private Claims: _____		

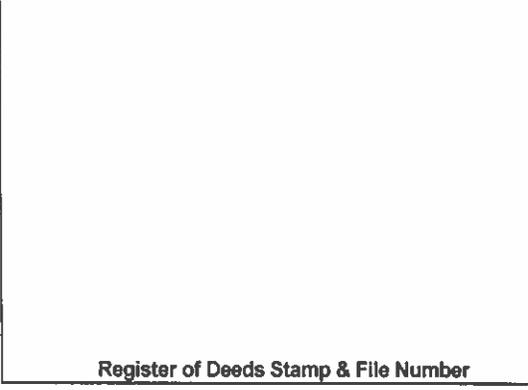

I, Carl T. Kiiskila, in a field survey on December 8, 2008 do hereby state that under requirements of PA 74, Michigan PA of 1970, the corner points mentioned in lines 1 and 2 above were in conformance with regulations and rules therefore as required in the current manual of survey instructions of the United States Department of the Interior, Bureau of Land Management or by a decree of a Court of Law and/or that the corner points mentioned in lines 3, 4 and 5 above were in conformance with the rules of the Michigan Board of Land Surveyors or by a Decree of a Court of Law; established, re-established, monumented, recovered, found as expressed below:

NOTE: Not more than 2 corners, all in the same town and range, may be recorded on this certificate.

	A	B	C	D	E	F	G	H	I	J	K	L	M
1													
2	6		5		4		3		2		1		
3													
4	7		8		9		10		11		12		
5													
6	18		17		16		15		14		13		
7													
8	19		20		21		22		23		24		
9													
10	30		29		28		27		26		25		
11													
12	31		32		33		34		35		36		
13													

A. Description of original monument and accessories and/or subsequent restoration:

10 - Not originally set by the GLO.
No other previous information found.

B. Description of corner evidence found and/or method applies in restoring or re-establishing corner:

10 - Set 5/8"x34" rebar with P.S. cap#33981 per standard BLM procedure.

C. Description of monument for corner and accessories established to perpetuate locating the position of the corner:

10 - 5/8"x 34" rebar with P.S. cap#33981.
Wit: N69°E 49.79' to set N&T on S side 40" Maple
S53°E 58.75' to set N&T on SW side 16" R. Pine
S59°W 38.81' to set N&T on SE side 12" Maple
N57°W 47.56' to set N&T on NE side 6" Maple
Set Blue Carsonite Post with loc. tag 33' East



Signed by: Carl T. Kiiskila
Surveyor's Michigan License No.: 33981

Date: 7-20-09