

96 DEC 31 PH 2:25

LAND CORNER RECORDATION CERTIFICATE
Filing Requirement of Act 74, Mich. P.A. 1970

For corners in

EMMET
(County)

Located In:

Corner Code #

1. Public Land Survey T 36N R 4W D-1(cc)
E.C.R.P #134
2. Property Controlling in Section S ___ T ___ R ___
S ___ T ___ R ___
3. Miscellaneous Property in Sec. S ___ T ___ R ___
S ___ T ___ R ___
4. Lot No. _____, Recorded Plat _____
5. Private Claims _____

Alvin A. Sizer
REGISTER OF DEEDS
LIBER A
PAGE 131

Register of Deeds Stamp & File Number

I, Thomas D. Swenor, in a field survey on DECEMBER 18, 1996, do hereby certify that under requirements of P.A. 74, Michigan P.A. of 1970, the corner points mentioned in lines 1 and 2 above were in conformance with regulations and rules therefore as required in the current manual of survey instructions of the United States Department of the Interior, Bureau of Land Management or by a decree of a Court of Law and/or that the corner points mentioned in lines 3, 4 and 5 above were in conformance with the rules of the Michigan Board of Land Surveyors or by a Decree of a Court of Law; established, re-established, monumented, re-monumented, recovered, found as expressed below:

	A	B	C	D	E	F	G	H	I	J	K	L	M
2	6		5		4		3		2		1		
3													
4	7		8		9		10		11		12		
5													
6	18		17		16		15		14		13		
7													
8	19		20		21		22		23		24		
9													
10	30		29		28		27		26		25		
11													
12	31		32		33		34		35		36		
13													

NOTE: Not more than 4 corners, all in the same town and range, may be recorded on this certificate.

A. Description of original monument and accessories and/or subsequent restoration:

D-1(cc),
1/4 Corner to Section 5, T36N R4W (closing corner)

(SEE BACK OF PAGE FOR HISTORY)

SURVEY &
REMONUMENTATION

MAY 05 1997

COMMISSION

B. Description of corner evidence found and/or method applied in restoring or reestablishing corner:

D1(cc),
Found 1/2" Re-Rod as set by M. Trowbridge. M. Trowbridge set closing corner 3.08 feet East of standard corner west, and on standard line between the South 1/4 Corner of Section 32, and the Southeast Corner of Section 32.

THIS CORNER IS ACCEPTED BY THE EMMET COUNTY REMONUMENTATION GROUP AS A FAITHFUL AND CAREFUL PERPETUATION OF THE ORIGINAL CORNER.

APPROVED LAND CORNER
P.A. 345 OF 1990
Emmet County

R. E. OELLS


2.30.96

C. Description of monument for corner and accessories established to perpetuate locating the position of the corner:

D-1(cc),
Found 1/2" Re-Rod and replaced with a 2" diameter, 30" long PVC Pipe with a Base magnet and a standard Brass Emmet County Remonumentation Cap. Further set a monument box to preserve corner position.

Witnesses:

- (4) N21°E 27.30' - (3) 40" Maple (found spike nail on east side of tree)
(5) N44°E 32.49' - Southwest Corner Telephone Pedestal
(6) West 3.05' - 2" diameter, 30" long PVC Pipe with a Base magnet and a standard Brass Emmet County Remonumentation Cap (standard corner)
(7) N70°W 71.67' - 24" Maple (set spike nail with 37282 cap)
(8) S13°W 41.09' - Power Pole (set spike nail with 37282 cap)

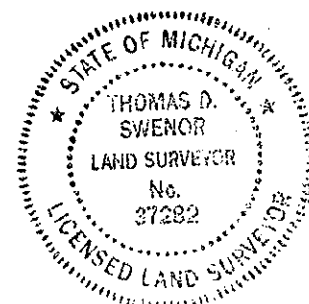

Signed by Thomas D. Swenor

Date December 26, 1996

Surveyor's Michigan License No. 37282

EMMET COUNTY REMONUMENTATION PROGRAM
 CORNER NO. 134
 T37N R4W - D-1(cc)

LIBER A
 PAGE 132

A. DESCRIPTION OF ORIGINAL MONUMENT AND ACCESSORIES AND/OR SUBSEQUENT RESTORATION:

Date	Surveyor	Found	(Witnesses)
1840	GLO	North 1/4 Corner Section 5, not set on correction line. Missing corner is set midway between closing corners east and west.	
Circa 1960	E.C.R.C.	Set 3/4" Pipe	(1) N15°E 29.81' - 24" Elm (2) S05°W 63.30' - 16" Elm (3) S53°W 58.37' - 12" Maple
		Not same corner as established by M.A. Trowbridge in 1985.	
1985	M.A. Trowbridge	Set 1/2" Re-Rod 3.08' East of Standard Corner to the West and on standard line between the South 1/4 Corner of Section 32, and the Southeast Corner of Section 32. See Liber 2, Pages 119 - 122, (LCRC)	(4) N21°E 27.36' - (3)40" Maple (5) N45°E 32.55' - SW Cor Tele Pedestal (6) West 3.08' - 1/2" re-rod (standard corner)