







STATE OF MICHIGAN EMMET COUNTY RECORDED

1995 DEC 19 PM 1:37

### APR 2 9 1996

# COMMISSION

## LAND CORNER RECORDATION CERTIFICATE

Filing Requirement of Act 74, Mich. P.A. 1970

County)	Located In:	Corner Code #	Glenna a. Sign
Public Land Survey	SECTION 8 T 36 N R 4 W	03	Slenna A. Signer REGISTER OF DEEDS
ECRP #85  2. Property Controlling in Section	T R R T R R Property in Section	S T R		Register of Deeds Stamp & File Number
4. Lot No  5. Private Claims	, Recorded Plat		A B C D E F G H I J K L
. Michael A. Trowbridge	, in a field survey on	12/8 10 95	4 7 8 9 10 11 12
do hereby certify that under in lines 1 and 2 above were in manual of survey instruction Management or by a decree 5 above were in conformant Decree of a Court of Law; expenses the conformant of the court of Law; expenses the conformant of the court of Law; expenses the court of Law; expens	requirements of P.A. 74, Michigan P.A n conformance with regulations and ruons of the United States Department of a Court of Law and/or that the corce with the rules of the Michigan Bostablished, re-established, monument	of 1970, the comer points mention les therefore as required in the current of the Interior, Bureau of La ner points mentioned in lines 3, 4 a ard of Professional Surveyors or b	ned 6 18 17 16 15 14 13- rent 7
as expressed below:	corners, all in the same town and	range may be recorded	11
on this certificate		ange, may be recorded	12 31 32 33 34 35 36
A. Description of origin D3NORTH 1/4 CORNER	al monument and accessories ar SECTION 8, T36N, R4W	d/or subsequent restoration:	13

SEE EMMET COUNTY REMONUMENTATION PROGRAM CHRONOLOGY OF GLO CORNER ON BACK SIDE OF THIS PAGE.

APPROVED LAND CORNER P.A. 345 OF 1990 **Emmet County** 

B. Description of corner evidence found and/or method applied in restoring or reestablishing corner:

D3.....FOUND 1/2" REROD 27463 AS DESCRIBED IN LAND CORNER RECORDATION CERTIFICATE RECORDED IN LIBER 2, PAGE 140.

AFTER REVIEWING EVIDENCE AVAILABLE TODAY, THE EMMET COUNTY REMONUMENTATION COMMITTEE MADE A DECISION TO ESTABLISH A NEW LOCATION FOR THIS CORNER. THE NEW CORNER LOCATION IS AT THE INTERSECTION OF A FENCE RUNNING WORTH AND A FENCE RUNNING EAST. THIS LOCATION WAS FAVORED BY THE COMMITTEE OVER THE LOCATION OF THE 1/2" REROD WHICH WAS BASED ON PROBATION. THE NEW CORNER LOCATION IS 200'+/- NORTH AND 150'+/- EAST OF THE 1/2" REROD. SEE SKETCH ON BACK SIDE OF THIS PAGE.

FOUND 1/2" REPOD WAS REMOVED AND THE NEW CORNER LOCATION WAS MONUMENTED AS NOTED BELOW.

C. Description of monument for corner and accessories established to perpetuate locating the position of the corner:

DB.....SET A E" DIAMETER PVC PIPE WITH A BASE MAGNET AND A STANDARD BRASS EMMET COUNTY REMONUMENTATION CAPIN THE NEW CORNER LOCATION ESTABLISHED 5: THE EMMET COUNTY RENONUMENTATION COMMITTEE AS NOTED ABOVE.

5" BASSWOOD, AZIMUTH 271", T.75" (NAIL AND 27463 CAP)

5" MAPLE, AZIMUTH 116", 29.33" (NAIL AND 27463 CAP)

7" BASSWOOD, AZIMUTH 156", 23.15" (NAIL AND 27463 CAF)

6" BEECH, AZIMUTH 242', 27.85' (NAIL AND 27463 CAP)



Signed by Mikacla	multo
Surveyor's Michigan License No.	0 07100

12/8	/3	5
------	----	---

FORM APPROVED BY MICHIGAN STATE BOARD OF PROFESSIONAL SURVEYORS, JAN. 29, 1971

### EMMET COUNTY REMONUMENTATION PROGRAM

### CHRONOLOGY OF GLO CORNER

REMON. CORNER # 85

LCRC # 36-04-D3

TOWNSHIP...MAPLE RIVER

REMONUMENTATION

EMMET COUNTY

CORNER NO. D3


MONUMENTED AS NOTED WITHIH

CORNER COMMON TO 5-8, T36H, R4W

SURVEYOR: MICHAEL A. TROWBRIDGE, PLS # 27463

DATE	SURVEYOR .	FOUND/SET	SET (WITNESSES)
1840	GLO/MULLETT	SET POST	BEECH 8 N12E 11 BEECH 8 S35E 11
11985	Trowbridge/survey L. 355, P. 309	set 1/2" rerod	11" poplar \$18% 16.38' 5" maple N70W 6.45' 6" maple N39E 40.40'
1985	Trowbridge/survey L. 355, P. 490 revised above surve	same .	same
1985	Trowbridge LCRC L. 2, P. 140	same	il same

3604-D3

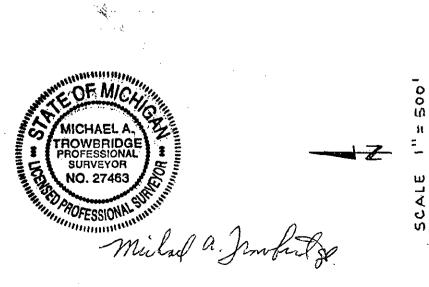

1/2" REROD — REMOVED LIBER 2, PAGE 140

2642.62

CORNER NO. C3

LIBER 2, PAGE 118

REMONUMENTATION CORNER NO. ES LIBERA, PAGE 46 EMMET GOUNTY

2491.64