

96 DEC 31 PM 2:25

LAND CORNER RECORDATION CERTIFICATE
Filing Requirement of Act 74, Mich. P.A. 1970

For corners in

EMMET
(County)

Located In:

Corner Code #

- | | | |
|------------------------------------|--------------------------|----------------|
| 1. Public Land Survey | T <u>36N</u> R <u>4W</u> | <u>E-1(cc)</u> |
| | T _____ R _____ | _____ |
| | T _____ R _____ | _____ |
| | T _____ R _____ | _____ |
| 2. Property Controlling in Section | S _____ T _____ R _____ | _____ |
| | S _____ T _____ R _____ | _____ |
| 3. Miscellaneous Property in Sec. | S _____ T _____ R _____ | _____ |
| | S _____ T _____ R _____ | _____ |

Thomas D. Swenor
REGISTERED SURVEYOR
LIBER A
PAGE 133

Register of Deeds Stamp & File Number

4. Lot No. _____, Recorded Plat _____
5. Private Claims _____

	A	B	C	D	E	F	G	H	I	J	K	L	M
2	6		5		4		3		2		1		
3													
4	7		8		9		10		11		12		
5													
6	18		17		16		15		14		13		
7													
8	19		20		21		22		23		24		
9													
10	30		29		28		27		26		25		
11													
12	31		32		33		34		35		36		
13													

I, Thomas D. Swenor, in a field survey on December 18, 1996, do hereby certify that under requirements of P.A. 74, Michigan P.A. of 1970, the corner points mentioned in lines 1 and 2 above were in conformance with regulations and rules therefore as required in the current manual of survey instructions of the United States Department of the Interior, Bureau of Land Management or by a decree of a Court of Law and/or that the corner points mentioned in lines 3, 4 and 5 above were in conformance with the rules of the Michigan Board of Land Surveyors or by a Decree of a Court of Law; established, re-established, monumented, re-monumented, recovered, found as expressed below:

NOTE: Not more than 4 corners, all in the same town and range, may be recorded on this certificate.

A. Description of original monument and accessories and/or subsequent restoration:

E-1(cc),
Section Corner common to Section 4, and Section 5, T36N R4W

(SEE BACK OF PAGE FOR HISTORY)

SURVEY &
REMONUMENTATION

MAY 05 1997

COMMISSION

B. Description of corner evidence found and/or method applied in restoring or reestablishing corner:

E-1(cc),
Found 1/2" Re-Rod Set by M.A. Trowbridge, and recorded in Liber 2, Page 118 (LCRC).
Corner as set by M.A. Trowbridge was set 17.16 feet west of Standard Corner at the Southwest Corner of Section 33, T36N R4W, and on line between the Southeast Corner of Section 32, T37N R4W, and the South 1/4 Corner of Section 32, T37N R4W

THIS CORNER IS ACCEPTED BY THE EMMET COUNTY REMONUMENTATION GROUP AS A FAITHFUL AND CAREFUL PERPETUATION OF THE ORIGINAL CORNER.

APPROVED LAND CORNER
P.A. 345 OF 1990
Emmet County

R. E. OELGOS

12-30-96

C. Description of monument for corner and accessories established to perpetuate locating the position of the corner:

E-1(cc),
Found 1/2" Re-Rod, and replaced with a 2" diameter, 30" long PVC Pipe with a Base magnet and a standard Brass Emmet County Remonumentation Cap. Further set a monument box to preserve corner position.


Witnesses:

- (5) S48°E 42.59' - (2) 12" Red Pine (spike nail with 37282 cap)
- (6) S07°E 36.17' - 18" Red Pine (set spike nail with 37282 cap)
- (8) East 17.18' - 2" diameter, 30" long PVC Pipe with a Base magnet and a standard Brass Emmet County Remonumentation Cap (standard corner)
- (9) N18°W 92.40' - 20" Elm (set spike nail with 37282 cap)
- (10) S34°W 82.10' - 12" Red Pine (set spike nail with 37282 cap)
- (11) North 6.0' - Road Centerline

Signed by Thomas D. Swenor

Date December 27, 1996

Surveyor's Michigan License No. 37282

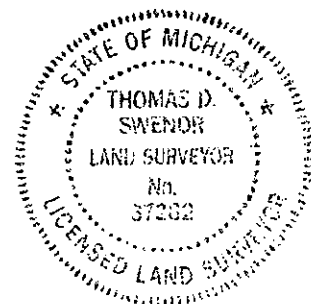

EMMET COUNTY REMONUMENTATION PROGRAM
 CORNER NO. 132
 T36N R4W - E-1(cc)

A. DESCRIPTION OF ORIGINAL MONUMENT AND ACCESSORIES AND/OR SUBSEQUENT RESTORATION:

Date	Surveyor	Found	(Witnesses)	
1840	GLO	Intersected North Boundary 26 West of Post. Set Post Corner Section 4 & 5	(1) (2)	Hemlock 14 S48W 14 Hemlock 8 S53E 17
Circa 1960	E.C.R.C.	Set 3/4" Iron Pipe on line between Sec cor common to Sec. 32 & 33, T37N R4W and Sec. 31 & 32, T37N R4W. Record Distance (17.26') west of Sec Cor. Common to Sec. 32 & 33.	(3) (4)	S3°E 71.68' - 5" Red Pine S62°W 59.69' - 8" Elm
1984	M.A. Trowbridge	Found 3/4" Pipe as set by E.C.R.C.		Went back with Robert Mitchell and reevaluated the position, see below.
1984	M.A. Trowbridge	Set 1/2" Re-Rod, foot below surface. surfaced with 1/2" re-rod	(5) (6) (7) (8)	S47°E 42.95' - (2)7" Red Pine S07°E 36.04' - 9" Red Pine N61°W 126.08' - SE Cor. tele. ped. East 17.16' - 1-1/2" solid iron shaft (recorded in L. 2, P. 118, LCRC)
1985	J.B. O'Neill	Found Trowbridge 1/2" re-rod		No witnesses
1985	J.E. Young	Found Trowbridge 1/2" re-rod		No witnesses.
1992	M.A. Trowbridge	Notes NW. Cor.		No witnesses
1996	R.E. Oelke	Found Trowbridge 1/2" Re-rod		No witnesses.
1996	Granger and Assoc.	Work performed in South part Sec. 4, T36N R4W		No information with regard to north line of Sec. 4, T36N R4W.