

APR 27 1995

**COMMISSION**

**LAND CORNER RECORDATION CERTIFICATE**  
**Filing Requirement of Act 74, Mich. P.A. 1970**

STATE OF MICHIGAN  
 EMMET COUNTY  
 RECORDED

1994 DEC 28 AM 11:04

For corners in EMMET

|                                       |                   |               |
|---------------------------------------|-------------------|---------------|
| (County)                              | Located In:       | Corner Code # |
|                                       | MAPLE RIVER       | G-3           |
|                                       | 36N 4W            |               |
| 1. Public Land Survey                 | T ___ R ___       | _____         |
| ECRP #59                              | T ___ R ___       | _____         |
|                                       | T ___ R ___       | _____         |
|                                       | T ___ R ___       | _____         |
| 2. Property Controlling in Section    | S ___ T ___ R ___ | _____         |
|                                       | S ___ T ___ R ___ | _____         |
| 3. Miscellaneous Property in Sec.     | S ___ T ___ R ___ | _____         |
|                                       | S ___ T ___ R ___ | _____         |
| 4. Lot No. _____, Recorded Plat _____ |                   |               |
| 5. Private Claims _____               |                   |               |

*Glenn B. Sizer*  
 REGISTER OF DEEDS

LIBER A  
 PAGE 65

Register of Deeds Stamp & File Number

I, Richard E. Oelke, in a field survey on 30 November, 1994

do hereby certify that under requirements of P.A. 74, Michigan P.A. of 1970, the corner points mentioned in lines 1 and 2 above were in conformance with regulations and rules therefore as required in the current manual of survey instructions of the United States Department of the Interior, Bureau of Land Management or by a decree of a Court of Law and/or that the corner points mentioned in lines 3, 4 and 5 above were in conformance with the rules of the Michigan Board of Land Surveyors or by a Decree of a Court of Law; established, re-established, monumented, re-monumented, recovered, found as expressed below:

**NOTE: Not more than 4 corners, all in the same town and range, may be recorded on this certificate.**

A. Description of original monument and accessories and/or subsequent restoration:

G-3, Section corner 3,4,9,10 T36N, R4W

SEE REVERSE SIDE FOR HISTORY

B. Description of corner evidence found and/or method applied in restoring or reestablishing corner:

G-3, Section corner 3,4,9,10 T36N, R4W

Found 1/2 " iron rod flush with the surface. closely fits existing occupation, centerline of road approximately 2.5' south, old N-S fence to the north.

- (5) N00°E, 29.03', fence post tagged 30095 E face
- (6) N80°E, 226.83', power pole tagged 30095 S face
- (7) S76°W, 137.22', 12" maple tagged 30095 N face
- (4) N80°W, 187.22', power pole tagged 30095 N face

APPROVED LAND CORNER  
 P.A. 345 OF 1990  
 Emmet County

R.E. Oelke  
27 DEC. 1994

C. Description of monument for corner and accessories established to perpetuate locating the position of the corner:

G-3, Section corner 3,4,9,10 T36N, R4W


At the 1/2" iron rod, set a 2" diam., 30" long, PVC pipe with a base magnet and a standard brass Emmet County Survey Remonumentation Program cap, 15" below the surface. This position is accepted as a careful and faithful reestablishment of the position of the original corner.

- N00°E, 29.08', fence post tagged 30095 E face
- N80°E, 226.83', power pole tagged 30095 S face
- S76°W, 137.17', 12" maple tagged 30095 N face
- N80°W, 187.19', power pole tagged 30095 N face

Signed by R.E. Oelke

Date 30 NOVEMBER 1994

Surveyor's Michigan License No. 33983

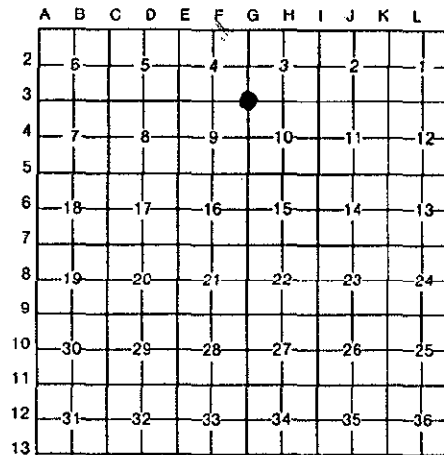

LIBER A  
 PAGE 66

EMMET COUNTY REMONUMENTATION PROGRAM  
 CORNER NO. 59

36-4-G3  
 T36N R4W 3/4/9/10  
 RINGLER RD.

| Date  | Surveyor   | Found   | Witnesses  | Notes   |
|-------|------------|---|--|---|
| -1840 | GLO        | Set post  |  | N02°E, 031ks, 30" sugar; S21°W, 221ks, 6" beech |
| -1884 | Swift      | (Book 1, page 28, Co. Surveyor notes), found cor.         |  |   |
| -1891 | Main       | (Twp. Hwy. records page 68), found post, set stone.       |  | N32°E, 93.7', 30" pine stump                    |
| -1895 | Main       | (Twp. Hwy. records page 172) found post.                  |  |   |
| -1916 | Main       | (Liber 1, page 46), found corner, cedar post.             |  |   |
| -1957 | ECRC       | Found 1" iron pipe.                                       | (1) N00°E, 25.7', end fence post<br>(2) N??°?, 25.3', E-W fence post   |   |
| -1984 | Trowbridge | LCRC (2/117) from 1957 witnesses set 1/2" iron rod.       | (3) N78°E, 112.73', 7" pine<br>(4) N78°W, 187.13', power pole  |   |
| -1991 | O'Neil     | Survey for Shier, found 1/2" iron rod.                    | (5) N00°E, 29.03', fence post tagged 30095 E face<br>(6) N80°E, 226.83', power pole tagged 30095 S face<br>(7) S76°W, 137.22', 12" maple tagged 30095 N face<br>(4) N80°W, 187.22', power pole tagged 30095 N face |   |
| -1993 | Oelke      | Survey for Benac, found 1/2" iron rod as witnesses above. |  |   |