

SURVEY & REMONUMENTATION

APR 27 1995 EMMET COUNTY REMONUMENTATION PROGRAM

COMMISSION

LAND CORNER RECORDATION CERTIFICATE
Filing Requirement of Act 74, Mich. P.A. 1970

STATE OF MICHIGAN
EMMET COUNTY
RECORDED

1994 DEC 14 PM 3:06

Glenn B. Sizemore
REGISTER OF DEEDS

For corners in
EMMET

(County)	Located in:	Corner Code #
1. Public Land Survey <i>ECRP #57</i>	SECTION 9 T 36 N R 04 W G5	
	T R	
	T R	
	T R	
2. Property Controlling in Section	S T R	
	S T R	
3. Miscellaneous Property in Sec.	S T R	
	S T R	

LIBER A
PAGE 47

Register of Deeds Stamp & File Number

4. Lot No. _____, Recorded Plat _____
5. Private Claims _____

	A	B	C	D	E	F	G	H	I	J	K	L
2	6		5		4		3		2		1	
3												
4	7		8		9		10		11		12	
5							15					
6	18		17		16		15		14		13	
7												
8	19		20		21		22		23		24	
9												
10	30		29		28		27		26		25	
11												
12	31		32		33		34		35		36	
13												

I, Michael A. Trowbridge, in a field survey on 04 / 30, 1994, do hereby certify that under requirements of P.A. 74, Michigan P.A. of 1970, the corner points mentioned in lines 1 and 2 above were in conformance with regulations and rules therefore as required in the current manual of survey instructions of the United States Department of the Interior, Bureau of Land Management or by a decree of a Court of Law and/or that the corner points mentioned in lines 3, 4 and 5 above were in conformance with the rules of the Michigan Board of Land Surveyors or by a Decree of a Court of Law; established, re-established, monumented, re-monumented, recovered, found as expressed below:

NOTE: Not more than 4 corners, all in the same town and range, may be recorded on this certificate.

A. Description of original monument and accessories and/or subsequent restoration:
G5

SEE BACK OF THIS FORM FOR CHRONOLOGY...


B. Description of corner evidence found and/or method applied in restoring or reestablishing corner:

G5...FOUND PIPE AND WITNESSES SAME AS IN CORNER RECORD OF LIBER 2, PAGE 20, AND AS NOTED IN CHRONOLOGY ON THE BACK OF THIS CERTIFICATE; I FOUND THIS POSITION (PIPE) TO BE BASED ON THE BEST AVAILABLE EVIDENCE FOR THIS CORNER.

APPROVED LAND CORNER
P.A. 345 OF 1990
Emmet County
R.E. Oake P.S. Co. Rep.
21 Nov. 1994

C. Description of monument for corner and accessories established to perpetuate locating the position of the corner:

G5...I SET A 2" DIAMETER, PVC PIPE WITH A BASE MAGNET & STANDARD BRASS EMMET COUNTY REMONUMENTATION CAP IN THE SAME POSITION AS THE PIPE NOTED IN "B" ABOVE....
....NEXT (3) WITNESSES PER L. 2, PG. 20, EMM. CO. COR. RECORDS....
NAIL & CAP # 27463 IN W. FACE 6" MAPLE S33'E 39.50'
NAIL & CAP # 27463 IN E. FACE 6" MAPLE S28'W 45.11'
NAIL & CAP # 27463 IN E. FACE 8" MAPLE N13'E 53.41'
....NEW WITNESSES....
NAIL & CAP # 27463 IN N. FACE 6" MAPLE AZ. 70°, 43.35'
NAIL & CAP # 27463 IN E. FACE 5" W. PINE 63.74' AZ. 40°
NAIL & CAP # 27463 IN W. FACE 8" W. PINE 59.94' AZ. 313°

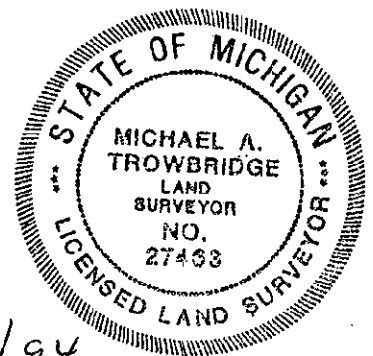

Signed by Michael A. Trowbridge Date 6/13/94
Surveyor's Michigan License No. 27463

EMMET COUNTY REMONUMENTATION PROGRAM

CHRONOLOGY OF GLO CORNER

REMON. CORNER # 57 LCRC # 36-04-G5 TOWNSHIP...MAPLE RIVER

CORNER COMMON TO SECTIONS 9-10-15-16, T36N, R4W

SURVEYOR: MICHAEL A. TROWBRIDGE, PLS # 27463

E.C.R. CONTRACT # 94-2

DATE	SURVEYOR	FOUND	SET (WITNESSES)
------	----------	-------	-----------------

1840	GLO	SET POST	ASPEN 4 S77E 20 PINE 5 S45W 28
1895	MAIN	COMMENCES AT POST	NOTES...GOV'T BRGS. STAND GOOD
(FROM BK. 1, PG. 172 OF MAPLE RIVER HWY. COMM. REC.)			
1914	MAIN	INTERSECTS AT POST...FROM BK. 2, PAGE 178	OF MAPLE RIVER HIGHWAY COMM. REC.
1978	EUGENE OSTLING	FOUND 1" I.B.	NO WITNESSES

FROM SURVEY FOR BILL ANDERSON, BY NORTHERN COUNTIES LAND SURVEY

1980	GREEN, COR. REC. LIBER 2, PAGE 20	FOUND 3/4" PIPE T-ROAD INTERSECTION	6" MAPLE S33E 39.50 6" MAPLE S28W 45.11 8" MAPLE N13E 53.41
------	-----------------------------------	-------------------------------------	---

1979-1981 GREEN, SURVEYS, L. 303, PG. 119, & (2) UNRECORDED SURVEYS, GRANGER & KIEBEL.....SHOWS SAME CORNER & WITNESSES AS IN GREEN, 1980 ABOVE.

1990-1993 TROWBRIDGE, SURVEYS, LIBER 430, PAGE 231, & LIBER 513, PAGE 614 SHOWS SAME CORNER & WITNESSES AS IN GREEN, 1980 ABOVE, & (1) ADDITIONAL WITNESS:
6" MAPLE AZ. 70° 43.35

1991 BIDSTRUP & YOUNG FOUND IRON PIPE AS RECORDED PER GREEN/1980 ABOVE.

3604-G5, MAT