

# LAND CORNER RECORDATION CERTIFICATE

Filing Requirement of Act 74, Mich. PA 1970

For Corners In: Emmet			
(County)	Located In	Corner Code #	
1. Public Land Survey	T 36 N R 6 W	J-6	
	T _____ R _____	_____	_____
2. Property Controlling in Section	S 14 T 36 N R 6 W	5	
	S _____ T _____ R _____	_____	_____
3. Miscellaneous Property in Section	S _____ T _____ R _____	_____	_____
	S _____ T _____ R _____	_____	_____


Register of Deeds Stamp & File Number

4. Lot No: \_\_\_\_\_ Recorded Plat: \_\_\_\_\_

5. Private Claims: \_\_\_\_\_

I, Carl T. Kiiskila, in a field survey on July 5, 2000 do hereby state that under requirements of PA 74, Michigan PA of 1970, the corner points mentioned in lines 1 and 2 above were in conformance with regulations and rules therefore as required in the current manual of survey instructions of the United States Department of the Interior, Bureau of Land Management or by a decree of a Court of Law and/or that the corner points mentioned in lines 3, 4 and 5 above were in conformance with the rules of the Michigan Board of Land Surveyors or by a Decree of a Court of Law; established, re-established, monumented, recovered, found as expressed below:

**NOTE: Not more than 2 corners, all in the same town and range, may be recorded on this certificate.**

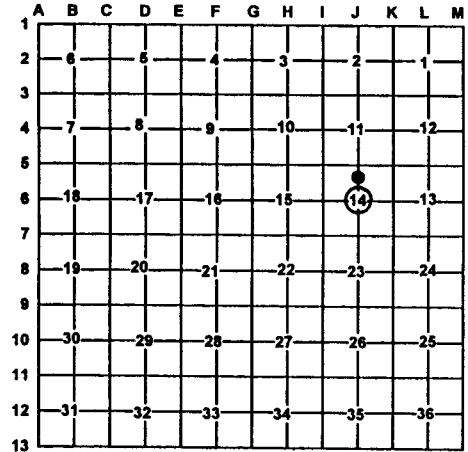

**A. Description of original monument and accessories and/or subsequent restoration:**

J-6 This corner position was not established during the original government survey.

5- This corner position was not established during the original government survey.

Liber 282, Page 31, N. DeYoung RLS #20705.  
1976 set the center while doing a survey in the west half of section 14.

**B. Description of corner evidence found and/or method applies in restoring or re-establishing corner:**

J-6 Established the center of section at the intersection of the North- South and East- West one-quarter lines. DeYoung's corner was removed during road construction.

5- Established the Northwest corner of the Southwest quarter of the Northeast Quarter of section 14 per B.L.M. instructions for the subdivision of a section.

**C. Description of monument for corner and accessories established to perpetuate locating the position of the corner:**

J-6 Set 5/8" x 32 rerod with PS cap #33981

5 Set 1" x 60" pipe with PS cap #33981 and Carsonite post

Wit: 14" Red Pine N01°E 56.58'  
Power Pole N77°E 99.68'  
18" Maple S30°E 52.87'  
14" Maple S57°W 73.49'  
Carsonite post North 33.00'

Wit: 16" White Pine S24°W 156.13'  
8" Tamarack S01°E 124.47'  
6" Maple S75°E 103.33'  
6" Maple N76°E 68.78'  
Center of S. State Rd. West 538'  
East/West fence line South 94'

Signed by: Carl T. Kiiskila  
Surveyor's Michigan License No.: 33981

Date: 8-1-00

