

**SURVEY & REMONUMENTATION**

APR 27 1995

**COMMISSION**

**LAND CORNER RECORDATION CERTIFICATE**  
**Filing Requirement of Act 74, Mich. P.A. 1970**

STATE OF MICHIGAN  
 EMMET COUNTY  
 RECORDED

DEC 27 AM 10:27

For corners in  
 EMMET

(County)	Located In:	Corner Code #
1. Public Land Survey SECTION 01 <i>ECRP # 67</i>	T <u>36 N</u> R <u>07 W</u>	M3
	T - R -	-
	T - R -	-
	T - R -	-
2. Property Controlling in Section	S - T - R -	-
	S - T - R -	-
3. Miscellaneous Property in Sec.	S - T - R -	-
	S - T - R -	-

*Alenna C. Sizer*  
 REGISTER OF DEEDS

LIBER A  
 PAGE 58

Register of Deeds Stamp & File Number

- 4. Lot No. \_\_\_\_\_, Recorded Plat \_\_\_\_\_
- 5. Private Claims \_\_\_\_\_

I, Michael A. Trowbridge, in a field survey on 12 / 08, 19 94, do hereby certify that under requirements of P.A. 74, Michigan P.A. of 1970, the corner points mentioned in lines 1 and 2 above were in conformance with regulations and rules therefore as required in the current manual of survey instructions of the United States Department of the Interior, Bureau of Land Management or by a decree of a Court of Law and/or that the corner points mentioned in lines 3, 4 and 5 above were in conformance with the rules of the Michigan Board of Land Surveyors or by a Decree of a Court of Law; established, re-established, monumented, re-monumented, recovered, found as expressed below:

	A	B	C	D	E	F	G	H	I	J	K	L
2	6	5	4	3	2							
3												
4	7	8	9	10	11							
5												
6	18	17	16	15	14							
7												
8	19	20	21	22	23							
9												
10	30	29	28	27	26							
11												
12	31	32	33	34	35							
13												

**NOTE: Not more than 4 corners, all in the same town and range, may be recorded on this certificate.**

A. Description of original monument and accessories and/or subsequent restoration:  
 M3  
 SEE BACK OF THIS FORM FOR CHRONOLOGY...

B. Description of corner evidence found and/or method applied in restoring or reestablishing corner:

M3  
 FOUND 5/8" REROD AND WITNESSES SET BY BONGIOVANNI PER LIBER 2, PAGE 17 (LCRC)  
 FOUND 5/8" REROD AS STATED BY TROWBRIDGE IN LIBER 2, PAGE 164, AS NOTED IN CHRONOLOGY ON BACK.  
 FOUND PLOW POINT AND ROCK AS STATED IN CHRONOLOGY ON BACK.  
 FOUND SCRAP METAL BELOW ROCK AND PLOW POINT.  
 FOUND CEDAR POST BELOW ROCK, PLOW POINT, AND SCRAP METAL AND 5/8" REROD.

APPROVED LAND CORNER  
 P.A. 345 OF 1990  
 Emmet County  
RE. CELKE  
27 Dec. 1994


\*\*NOTE\*\*  
 WE PLACED ALL EVIDENCE, EXCEPT 5/8" REROD, IN THE BOTTOM OF THE HOLE BELOW THE EMM. CO. MRK.

I FOUND THE 5/8" REROD AND THE ABOVE EVIDENCE, NOTED IN "B", TO REPRESENT THE BEST AVAILABLE EVIDENCE FOR THIS CORNER.

C. Description of monument for corner and accessories established to perpetuate locating the position of the corner:

M3  
 I SET A 2" DIAMETER, PVC PIPE WITH A BASE MAGNET AND STANDARD BRASS EMMET COUNTY REMONUMENTATION CAP IN THE SAME POSITION AS THE 5/8" REROD NOTED IN "B" ABOVE...

- .....WITNESSES.....
- SPIKE\CAP #27463 E.FC. 40" MAPLE 34.70' MEASURED (34.60' REC.) N33°W
  - SPIKE\CAP #27463 N.FC. 5" IRONWOOD 30.98' MEASURED (30.96' REC.) S63°W
  - SPIKE\CAP #27463 S.FC. 20" MAPLE 27.59' MEASURED (27.60' REC.) S77°E
  - IRON PIPE (0.09' O.D.) 47.15' MEASURED (47.08' REC.) S47°W
  - SPLINE SHAFT (0.09' O.D.) 46.73' S47°W
  - SET NAIL\CAP #27463 IN SW.FC. 12" MAPLE (1' ABOVE GRADE) 52.95' S36°E

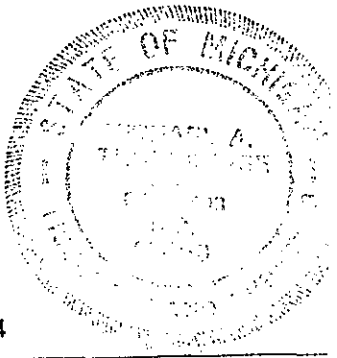

Signed by Michael A. Trowbridge Date \_\_\_\_\_  
 Surveyor's Michigan License No. 27463

12-8-94

CHRONOLOGY OF GLO CORNER

LIBER A  
PAGE 58

REMON. CORNER # 67      LCRC # 36-07-M3      TOWNSHIP...FRIENDSHIP


SOUTHEAST CORNER SECTION 1-36-7

SURVEYOR: MICHAEL A. TROWBRIDGE, PLS # 27463

E.C.R. CONTRACT # 94-

DATE	SURVEYOR	FOUND	SET (WITNESSES)
1840	GLO	SET POST	HEMLOCK 30 N79W 79 HEMLOCK 36 S04E 34
1897	KEEP L1,P10-11 NOTES,B3,P57-61	FOUND OLD POST	BEECH 8 S31W 60 SUGAR 7 N35W 55 1/2
1980	BONGIOVANNI, L2,P17(LCRC)	FD. PLOW PT. & ROCK	SET REROD & CAP & WITN. 24" MAPLE S78E 27.44 36" MAPLE N83W 34.68 20" MAPLE S31W 51.43 IRON PIPE S47W 47.08
1986	TROWBRIDGE (UNREC. SURVEY) (MARSH,8665)	FD. 5/8" REROD	40" MAPLE N33W 34.60 20" MAPLE S77E 27.60 5" IRONWOOD S63W 30.96
1987	TROWBRIDGE L2,P164 (LCRC)	SAME AS IN 1986	SAME CORNER & WITN.S AS IN 1986

3607-M3

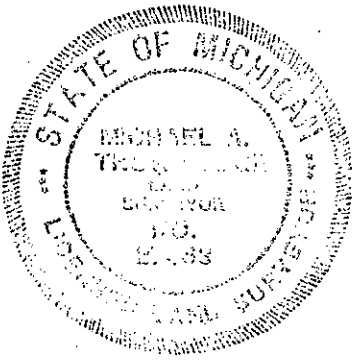

*Michael A. Trowbridge*