

EMMET &
REMONUMENTATION

MAY 05 1997

LAND CORNER RECORDATION CERTIFICATE
Filing Requirement of Act 74, Mich. P.A. 1970

STATE OF MICHIGAN
EMMET COUNTY
RECORDED

96 DEC 31 PM 2:25

Alma B. Stipe
REGISTER OF DEEDS

COMMISSION

For corners in EMMET Located In: _____ Corner Code # _____
(County)

- | | | |
|------------------------------------|--------------------------|-------|
| 1. Public Land Survey | T <u>37N</u> R <u>4W</u> | D5 |
| | T _____ R _____ | _____ |
| ECRP #118 | T _____ R _____ | _____ |
| | T _____ R _____ | _____ |
| 2. Property Controlling in Section | S _____ T _____ R _____ | _____ |
| | S _____ T _____ R _____ | _____ |
| 3. Miscellaneous Property in Sec. | S _____ T _____ R _____ | _____ |
| | S _____ T _____ R _____ | _____ |

LIBER A
PAGE 123

Register of Deeds Stamp & File Number

4. Lot No. _____, Recorded Plat _____
5. Private Claims _____

I, MICHAEL A. TROWBRIDGE, in a field survey on DECEMBER 13, 1996, do hereby certify that under requirements of P.A. 74, Michigan P.A. of 1970, the corner points mentioned in lines 1 and 2 above were in conformance with regulations and rules therefore as required in the current manual of survey instructions of the United States Department of the Interior, Bureau of Land Management or by a decree of a Court of Law and for that the corner points mentioned in lines 3, 4 and 5 above were in conformance with the rules of the Michigan Board of Professional Surveyors or by a Decree of a Court of Law; established, re-established, monumented, re-monumented, recovered, found as expressed below:

1	A	B	C	D	E	F	G	H	I	J	K	L	M
2		6		5		4		3		2		1	
3													
4		7		8		9		10		11		12	
5													
6		18		17		16		15		14		13	
7													
8		19		20		21		22		23		24	
9													
10		30		29		28		27		26		25	
11													
12		31		32		33		34		35		36	
13													

NOTE: Not more than 4 corners, all in the same town and range, may be recorded on this certificate.

A. Description of original monument and accessories and/or subsequent restoration:

5D, CORNER COMMON TO SECTIONS 8 & 17, T37N, R4W

SEE BACK FOR CORNER HISTORY

B. Description of corner evidence found and/or method applied in restoring or reestablishing corner:

5D, CORNER COMMON TO SECTIONS 8 & 17, T37N, R4W

SET CORNER IN CENTERLINE OF EAST & WEST GRAVEL ROAD ON FENCE LINE NORTH & FENCE LINE SOUTH.

APPROVED LAND CORNER
P.A. 345 OF 1990
Emmet County

P. E. DEWES

12.30.96


C. Description of monument for corner and accessories established to perpetuate locating the position of the corner:

5D, CORNER COMMON TO SECTIONS 8 & 17, T37N, R4W

Set at the corner a 2" diameter, 30" long, PVC pipe with a base magnet and a standard brass Emmet county Survey Remonumentation Program cap. This position is accepted as the best available evidence of the position of the original corner.

WITNESSES:

AZIMUTH	7°	40.90'	Fence post, cap #27463 & nail in east face
AZIMUTH	183°	49.10'	Verticle railroad tie, cap #27463 in east face
AZIMUTH	230°	63.14'	20" Triple Beech, cap # 27463 in north face
AZIMUTH	256°	81.07'	Quad Maple, cap #27463 in north face

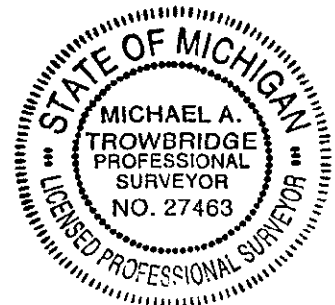

Signed by Michael A. Trowbridge Date 12/16/1996

Surveyor's Michigan License No. 27463

EMMET COUNTY REMONUMENTATION PROGRAM

LIBER A
PAGE 124

CHRONOLOGY OF GLO CORNER

REMON. CORNER # 118 LCRC # 37-04-D5 TOWNSHIP...MCKINLEY

CORNER COMMON TO SECTIONS 8 & 17 , T37 N, R4W

DATE	SURVEYOR	FOUND/SET	WITNESSES
1840	GLO	SET POST	(1)BEECH 16 N1W 31 (2)BEECH 6 S31E 27
1909	SWIFT	SET POST	(3)HEMLOCK 12 N64E 16'9" (4)HEMLOCK 28 N90W 11'11"
1915	MAIN	SET POST	"NO QUARTER SECTION BEARINGS FOUND"

COMMENT.....MAIN'S 1915 RECORD ABOVE NOTES "OLD POINT OF STAKE 2' EAST
FROM WHERE I SET THE 1/4 S.P."