

**SURVEY & REMONUMENTATION**

APR 29 1996

**LAND CORNER RECORDATION CERTIFICATE**  
**COMMISSION Filing Requirement of Act 74, Mich. P.A. 1970**

STATE OF MICHIGAN  
 EMMET COUNTY  
 RECORDED

1995 DEC 18 PM 3:51

*Glenna L. Sipe*  
 REGISTER OF DEEDS

For corners in

EMMET

(County)

Located In:

Corner Code #

CENTER TOWNSHIP

- |                         |                         |       |
|-------------------------|-------------------------|-------|
| 1. Public Land Survey   | T 37N R 5W              | E-3   |
|                         | T _____ R _____         | _____ |
| <b>ECRP #88</b>         | T _____ R _____         | _____ |
|                         | T _____ R _____         | _____ |
| 2. Property Controlling | S _____ T _____ R _____ | _____ |
| in Section              | S _____ T _____ R _____ | _____ |
| 3. Miscellaneous        | S _____ T _____ R _____ | _____ |
| Property in Sec.        | S _____ T _____ R _____ | _____ |

**LIBER A PAGE 78**

Register of Deeds Stamp & File Number

4. Lot No. \_\_\_\_\_, Recorded Plat \_\_\_\_\_  
 5. Private Claims \_\_\_\_\_

Richard E. Oelke 15 December 95

I, \_\_\_\_\_, in a field survey on \_\_\_\_\_, 19\_\_\_\_\_, do hereby certify that under requirements of P.A. 74, Michigan P.A. of 1970, the corner points mentioned in lines 1 and 2 above were in conformance with regulations and rules therefore as required in the current manual of survey instructions of the United States Department of the Interior, Bureau of Land Management or by a decree of a Court of Law and/or that the corner points mentioned in lines 3, 4 and 5 above were in conformance with the rules of the Michigan Board of Land Surveyors or by a Decree of a Court of Law; established, re-established, monumented, re-monumented, recovered, found as expressed below:

**NOTE: Not more than 4 corners, all in the same town and range, may be recorded on this certificate.**

	A	B	C	D	E	F	G	H	I	J	K	L	M
2	6		5		4		3		2		1		
3					●								
4	7		8		9		10		11		12		
5													
6	18		17		16		15		14		13		
7													
8	19		20		21		22		23		24		
9													
10	30		29		28		27		26		25		
11													
12	31		32		33		34		35		36		
13													


A. Description of original monument and accessories and/or subsequent restoration:

E-3, Section corner 4.5,8,9 T37N, R5W  
 1840 GLO Set post  
 1907 Main Fd post and witnesses ran line bet. sec. 8 & 9  
 1994 Oelke Fd bent ardox nail (not accepted as corner), also occupation fences and possible witnesses set by persons unknown.  
 Recovery done while traversing to N 1/4 corner of Section 9.

B. Description of corner evidence found and/or method applied in restoring or reestablishing corner:

E-3, Section corner 4.5,8,9 T37N, R5W  
 Retraced Main's 1907 survey, existing fences fit very well with Main's survey. Split old east and west right-of-way fences of Lechowicz Road to establish easting of corner, extended old east-west fence easterly to establish northing of corner. This point falls in approximate center of Lechowicz Road and an unnamed road running east. North 1/2 mile bet. secs. 8 & 9, (2661.12' Main)(2662.90' unnamed fences). Old Fence corner is west 32.4'.

APPROVED LAND CORNER  
 P.A. 345 OF 1990  
 Emmet County  
*Richard E. Oelke*  
 15 DEC 95

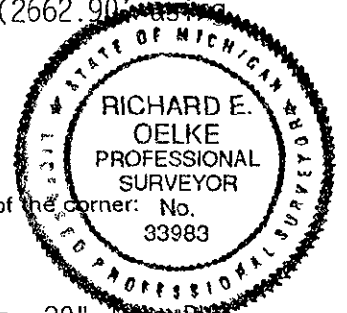

C. Description of monument for corner and accessories established to perpetuate locating the position of the corner:

E-3, Section corner 4.5,8,9 T37N, R5W  
 At the point determined above from existing fences, set a 2" dia. 30" long PVC pipe with a base magnet and a standard brass Emmet County Survey Remonumentation Program cap. This position is accepted as the best available evidence of the position of the original corner.  
 N33°E, 66.34', 6" Maple, tagged 33983 in SE face  
 S23°E, 46.82', 12" Maple, fd spike in NE face  
 S45°W, 45.04', 5" Maple(twin), tagged 33983 in NW face  
 S84°W, 39.95', 12" Birch, fd spike in NE face  
 N70°W, 35.09', 4" Maple, tagged 3398 in NE face

Signed by Richard E. Oelke Date 15 DECEMBER 95

Surveyor's Michigan License No. 33983