

MICHIGAN
DEPARTMENT OF CONSERVATION
FORESTRY DIVISION

LAND CORNER RECORD

T. 37 N. R. 5 W.


Emmet COUNTY

DESCRIPTION OF CORNER 1/4 corner on south side Section 32

CORNER MONUMENT Set 1" pipe with 4" brass cap

DATE MONUMENT PLACED AND WITNESSED June 25, 1962

WITNESSES TO CORNER.....

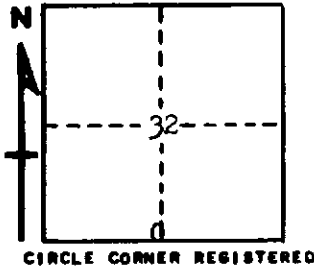

AND

12" Twin Elm N 27 E 44.6'

DESCRIPTION IN DETAIL AS TO HOW CORNER WAS LOCATED AND IDENTIFIED OR RESTORED.

This corner was restored while making a survey in this area. Set corner midpoint between standard section corners at the same latitude as the recovered 1/4 corner for Section 5. Falls 10 links east of 1/4 corner of Section 5. Could find no evidence of a previous corner here.

1/4 for Section 5, T 36 N, R 5 W is 10 links west.

SURVEYOR'S SEAL

SIGNED Kenneth J. Ostling DATE July 16, 1962
REGISTERED LAND SURVEYOR